


DATE _____

TOWN OF LEXINGTON — BOARD OF PUBLIC WORKS
WATER DIVISION

Sketch of Service Here

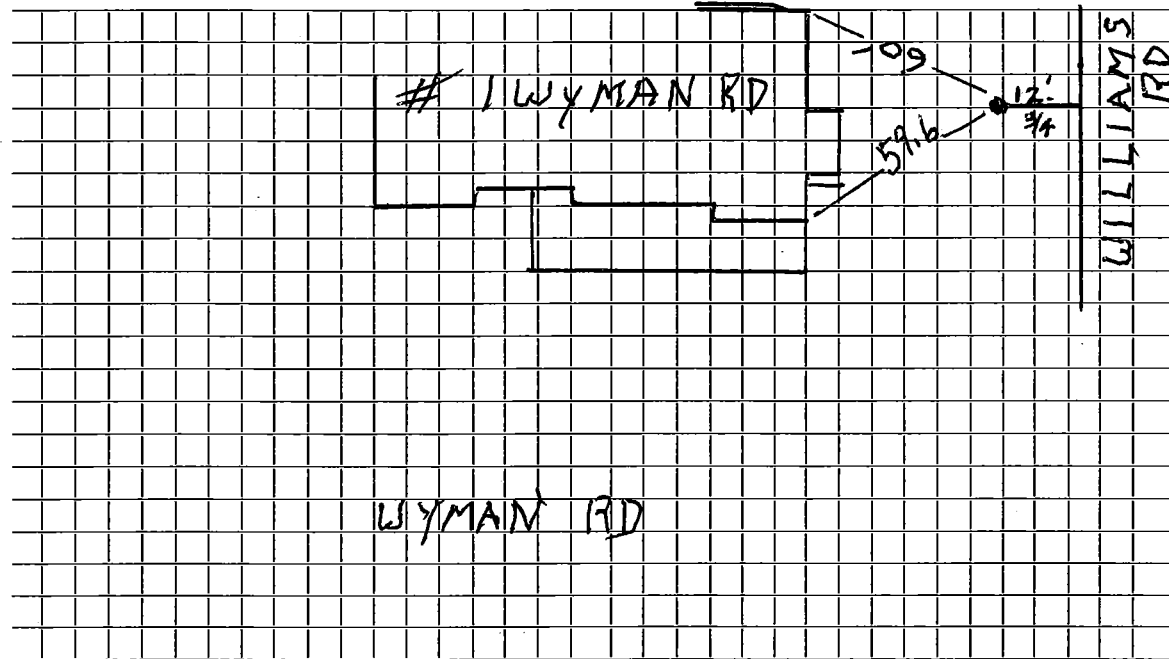

Connection made in Williams Rd Street. Work completed 4/19/11

Remarks:

.....

.....