

WATER SERVICE RECORD

Name William C. Schlaich

Service No. 290

Address lot 20 30 Wyman Road

Location

~~Repair-Renewal~~—New Service SERVICE IN TO CURB

Com m. 3-3-58


Date	Material	Amount	Total	Date	Amount
12/19/57	Labor	3 55			
	10% overhead	36	3 91		<u>NON CHARGE</u>
	55' - 3/4" Copper tubing @ .37	20 35		11/9/53	Labor 2 46
	1 - 3/4" Cx 1/2" I.W.H. Stop & Waste	4 96		23' - 3/4" Copper tubing @ .3629	8 35
	1 hr. Trucking		75	1 - 3/4" C corp-cock	4 33
			29 97	1 - 3/4" Cx 3/4" C. curb-cock	4 67
				1 box and rod	3 90
				1 hr. trucking	75
					<u>24 46</u>
				12/19/57	1 - 1/2 Straight tailpiece 50
					1 - 1/2 Offset tailpiece 50
					<u>25 46</u>
				12-16-57	Deposit \$ 75 00
				3-3-58	Refund 45 03
					<u>\$ 29 97</u>

DATE _____

TOWN OF LEXINGTON — BOARD OF PUBLIC WORKS

WATER DIVISION

Sketch of Service Here

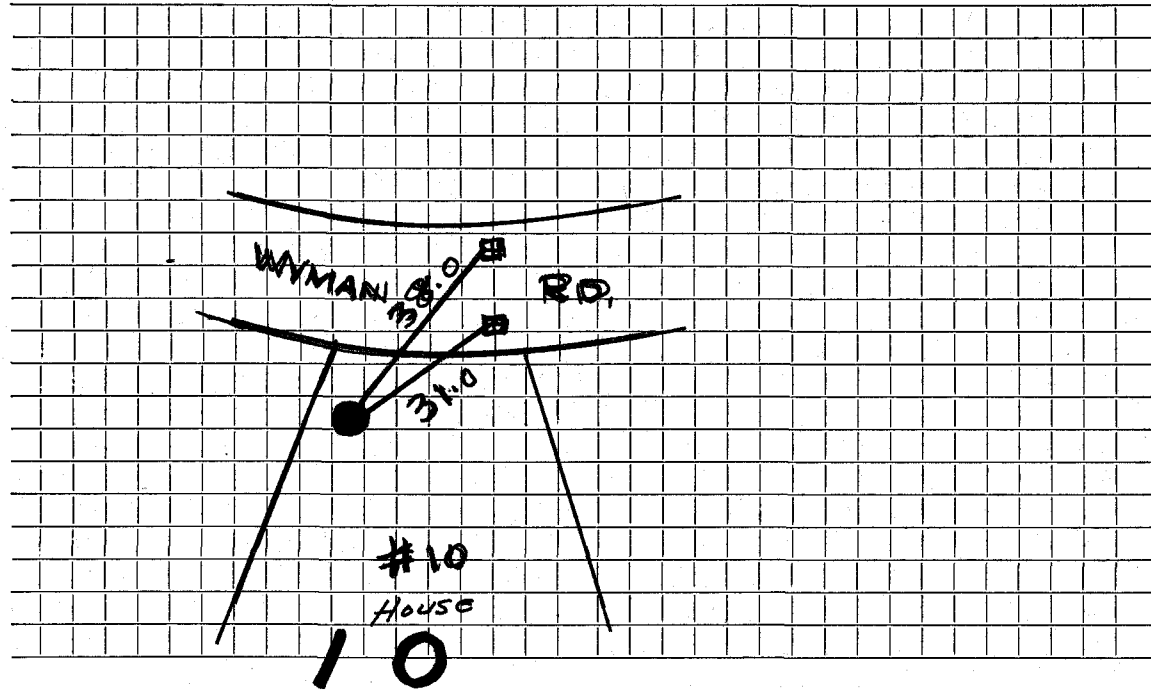

Connection made in Street. Work completed

Remarks:
.....
.....