

WATER SERVICE RECORD

Name

11 11

Service No.

Address

lot ~~10~~ 32 Wyman Road

Location

11 Wyman Road

Repair—Renewal—New Service

SERVICE IN TO CURB


Date	Material	Amount	Total	Date	Amount
11-24-54					
	55' 3/4" Copper				NON CHARGE
	1 3/4" X 1/2" I.W.H. Stop + Waste			11/9/53	Labor 2 46
					6' - 3/4" Copper tubing @ .3629 2 18
					1 - 3/4" C. corp-cock 4 33
					1 - 3/4" C x 3/4" C. curb-cock 4 67
					1 box and rod 3 90
					1 hr. trucking 75
					18 29

DATE _____

TOWN OF LEXINGTON — BOARD OF PUBLIC WORKS

WATER DIVISION

Sketch of Service Here

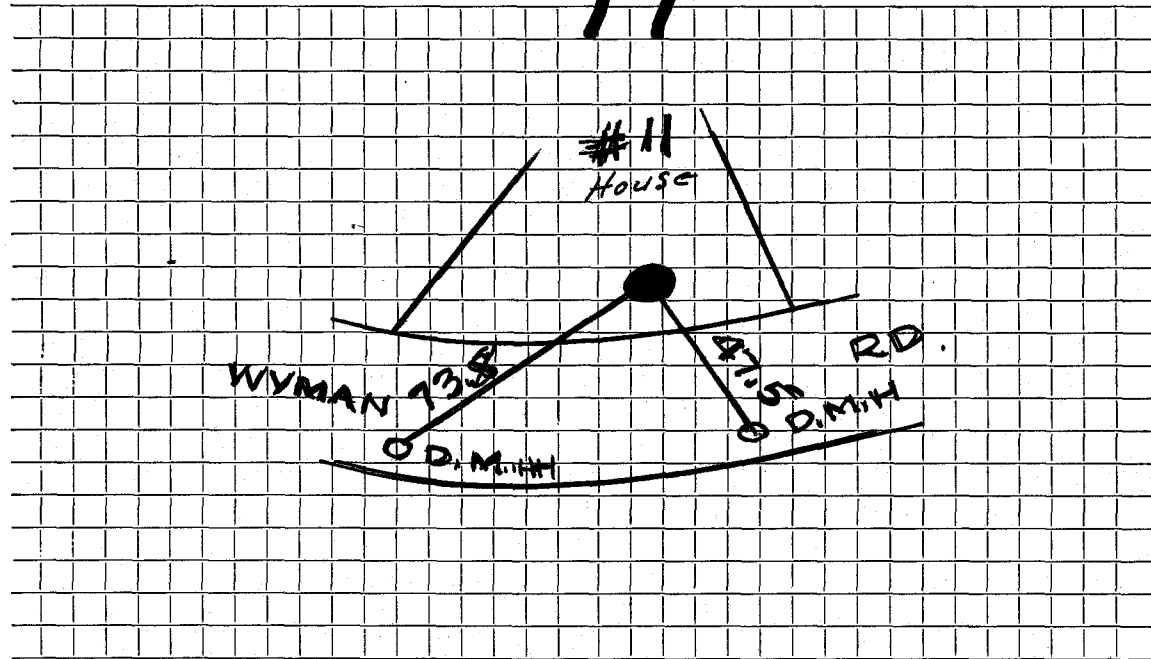

Connection made in Street. Work completed

Remarks:
.....
.....