

WATER SERVICE RECORD

Name 9 79

Service No.

Address lot 17 ~~24~~ Wyman Road

Location 19 WYMAN ROAD

Repair - Renewal - New Service SERVICE IN TO CURB


Date	Material	Amount	Total	Date	Amount
4-25-55					
	66' 3/4" Copper				NON CHARGE
	1 3/4" C. X 1/2" I.W.H. Stop + Waste			11/10/53	Labor 2 73
	1 3/4" C. UNION			7' - 3/4" Copper tubing @ .3629	2 54
				1 - 3/4" C. corp-cock	4 33
				1 - 3/4" C x 3/4" C. curb-cock	4 67
				1 box and rod	3 90
				1 hr. trucking	75
					<u>18 92</u>

DATE _____

TOWN OF LEXINGTON — BOARD OF PUBLIC WORKS

WATER DIVISION

Sketch of Service Here

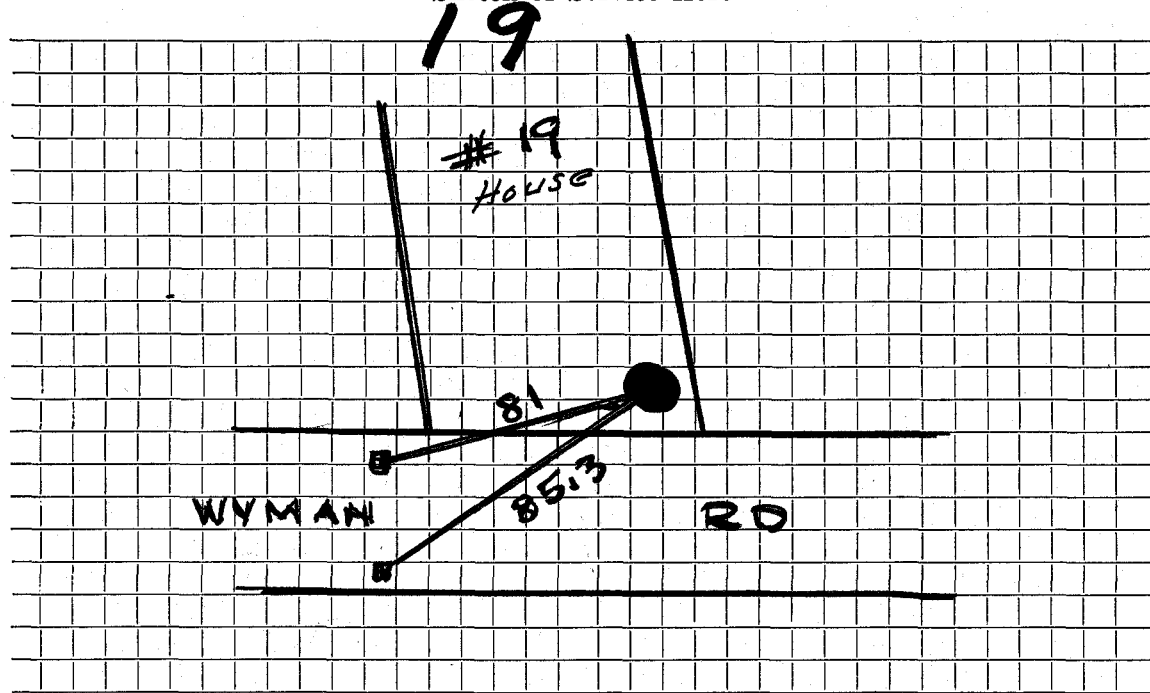

Connection made in Street. Work completed

Remarks:
.....
.....