

### WATER SERVICE RECORD

Name

25 20

Service No.

Address

lot 31 25 Wyman Road

Location

20 WYMAN ROAD

~~Repair-Renewal~~ - New Service

SERVICE IN TO CURB


Date	Material	Amount	Total	Date	Amount
10-10-55	55' 3/4" Copper				
	1 3/4" X 1/2" I.W.H. Stop + Waste				
					<u>NON CHARGE</u>
				11/10/53	Labor 2 74
					23' - 3/4" Copper tubing @ .3629 8 35
					1 - 3/4" C. corp-cock 4 33
					1 - 3/4" C. x 3/4" C. curb-cock 4 67
					1 box and rod 3 90
					1 hr. trucking 75
					<u>24 74</u>

DATE \_\_\_\_\_

TOWN OF LEXINGTON — BOARD OF PUBLIC WORKS

WATER DIVISION

Sketch of Service Here

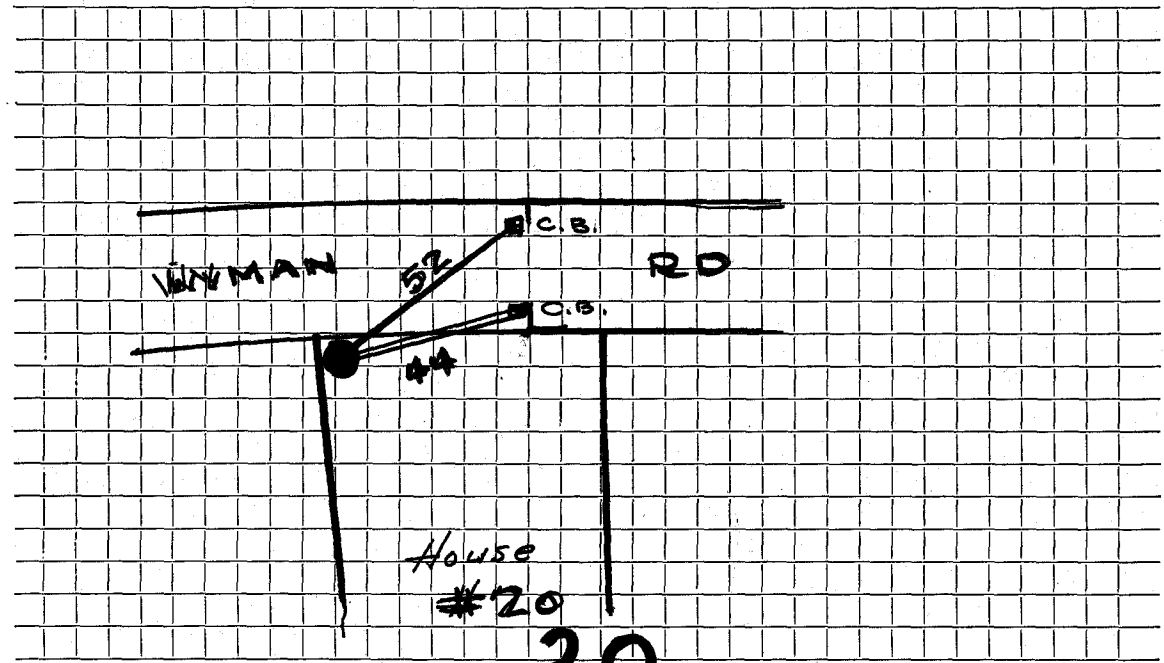

Connection made in ..... Street. Work completed .....

Remarks: .....  
.....  
.....