

WATER SERVICE RECORD

Name

8 21

Service No.

Address

lot 18 ~~22~~ Wyman Road

Location

21 WYMAN

~~Repair - Renewal~~

New Service SERVICE IN TO CURB


Date	Material	Amount	Total	Date	Amount
6-17-59					
	80' 3/4" Copper				NON CHARGE
	1 3/4" X 1/2" I. W. H. Stop & Waste			11/10/53	Labor 2 74
	1 3/4" 3 Part Union			8' - 3/4" Copper tubing @ .3629	2 90
				1 - 3/4" C. corp-cock	4 33
				1-3/4" Cx3/4" C. curb-cock	4 67
				1 box add rod	3 90
				1 hr. trucking	75
					19 29

DATE _____

TOWN OF LEXINGTON — BOARD OF PUBLIC WORKS

WATER DIVISION

Sketch of Service Here

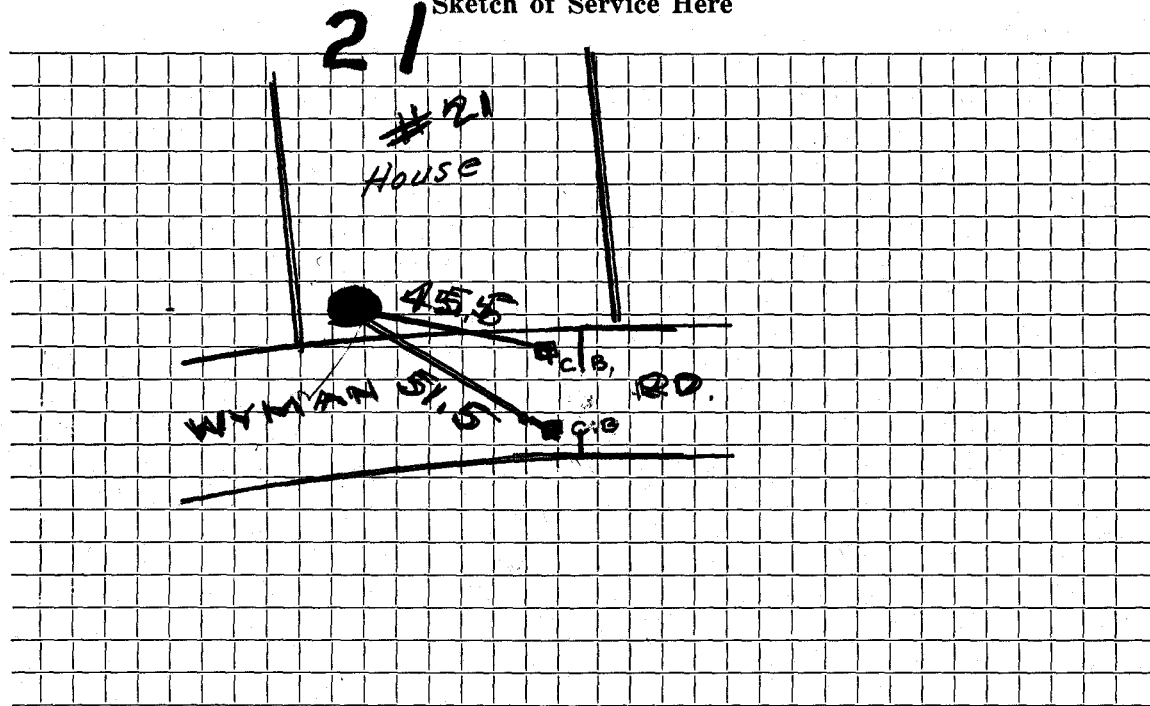

Connection made in Street. Work completed

Remarks:
.....
.....