

WATER SERVICE RECORD

Name 26 22

Service No.

Address lot 32 ~~21~~ Wyman Road

Location 22 Wyman Road

Repair ~~Renewal~~ - New Service SERVICE IN TO CURB


Date	Material	Amount	Total	Date	Amount
9-1-55					
	60' 3/4" Copper				NON CHARGE
	1 3/4" C. X 1/2" I.W.H. STop + Waste			11/10/53	Labor 2 74
					21' - 3/4" Copper tubing @ .3629 7 62
					1 - 3/4" C. corp-cock 4 33
					1 - 3/4" C. curb-cock 4 67
					1 box and rod 3 90
					1 hr. trucking 75
					24 01

DATE _____

TOWN OF LEXINGTON — BOARD OF PUBLIC WORKS

WATER DIVISION

Sketch of Service Here

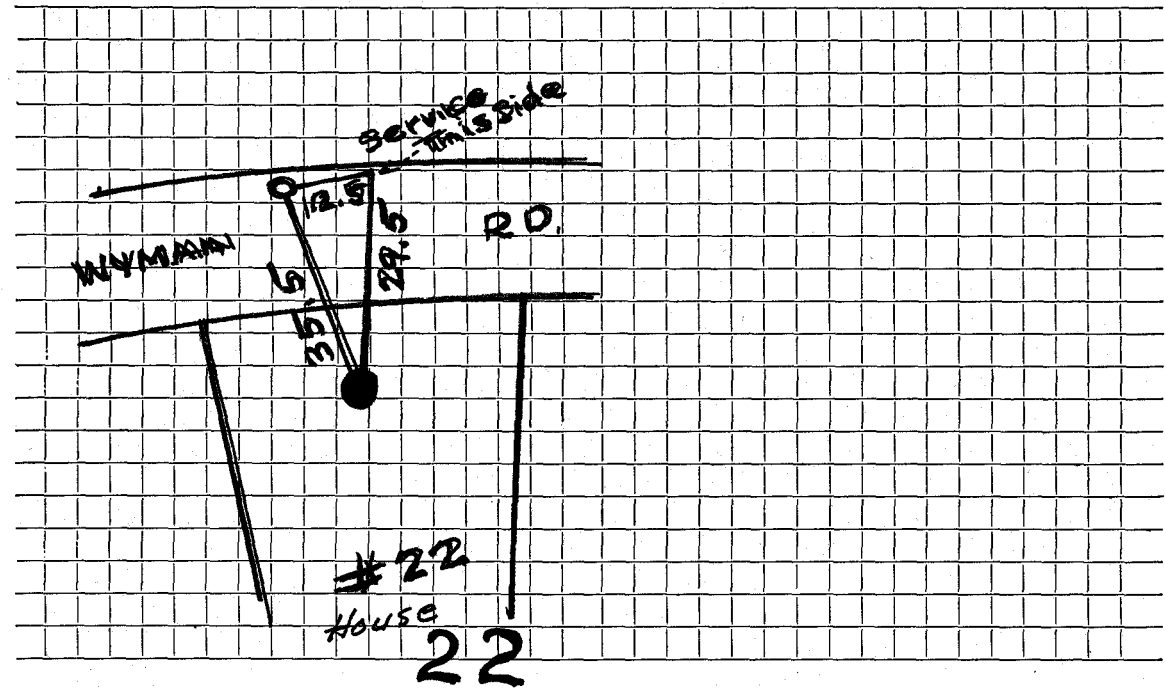

Connection made in Street. Work completed

Remarks:
.....
.....