

WATER SERVICE RECORD

Name

27 24

Service No.

Address

lot 33 ~~15~~ Wyman Road

Location

24 Wyman Road

~~Repair-Renewal~~ - New Service SERVICE IN TO CURB

Date	Material	Amount	Total	Date	Amount
3-21-57					
	58' 3/4" Copper				NON CHARGE
	1 3/4" X 1/2" I. W. H. Stop + Waste			11/10/53	Labor 2 74
				21' -	3/4" Copper tubing @ .3629 7 62
				1 -	3/4" C. corp-cock 4 33
				1 -	3/4" C. x 3/4" C. curb-cock 4 67
				1	box and rod 3 90
				1	hr. trucking 75
					<u>24 01</u>


DATE _____

TOWN OF LEXINGTON — BOARD OF PUBLIC WORKS

WATER DIVISION

Sketch of Service Here

24

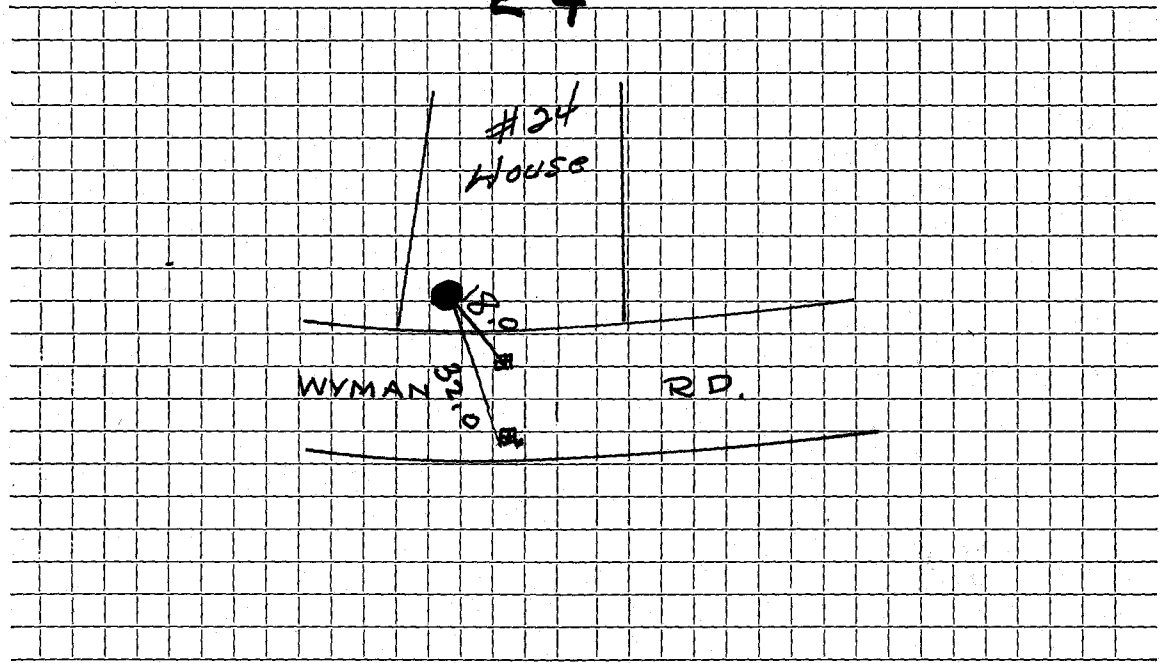

Connection made in Street. Work completed

Remarks:
.....
.....