

WATER SERVICE RECORD

Name

28 26

Service No.

Address

lot ~~34~~ ~~27~~ Wyman Road

Location

26 Wyman Road

Repair ~~x~~ Renewal — New Service


SERVICE IN TO CURB

Date	Material	Amount	Total	Date	Amount
6-4-56					
	70' 3/4" Copper				NON CHARGE
	1 3/4"C. X 1/2" I.W.H. STOP + Waste			11/10/53	Labor 2 74
	2 3/4"C. 3 Part UNIONS			22' - 3/4" Copper tubing @ .3629	7 98
				1 - 3/4"C. corp-cock	4 33
				1 - 3/4"C x 3/4"C. curb-cock	4 67
				1 box and rod	3 90
				1 hr. trucking	75
					24 31

TOWN OF LEXINGTON — BOARD OF PUBLIC WORKS

WATER DIVISION

Sketch of Service Here

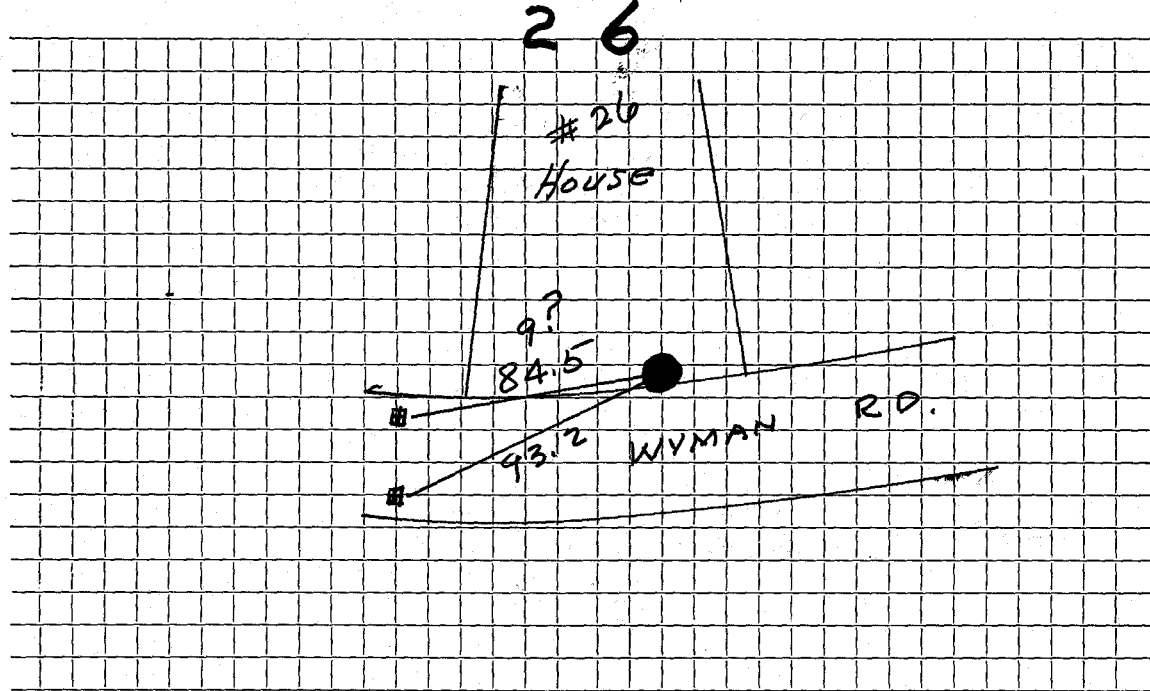

Connection made in Street. Work completed

Remarks:

.....

.....