

## WATER SERVICE RECORD

Name

5 27

Service No.

Address

lot 13 ~~10~~ Wyman Road

Location

27 WYMAN Road

~~Repair - Renewal~~ - New Service

SERVICE IN TO CURB


Date	Material	Amount	Total	Date	Amount
5-28-55					
	55' 3/4" Copper				NON CHARGE
	1 3/4" X 1/2" I.W.H. Stop + Waste			11/10/53	Labor 2 74
				8' - 3/4"	Copper tubing @ .3629 2 90
				1 - 3/4" C.	corp-cock 4 33
				1 - 3/4" C x 3/4" C.	curb-cock 4 67
				1 box and rod	3 90
				1 hr. trucking	75
					19 29

DATE \_\_\_\_\_

TOWN OF LEXINGTON — BOARD OF PUBLIC WORKS

WATER DIVISION

Sketch of Service Here

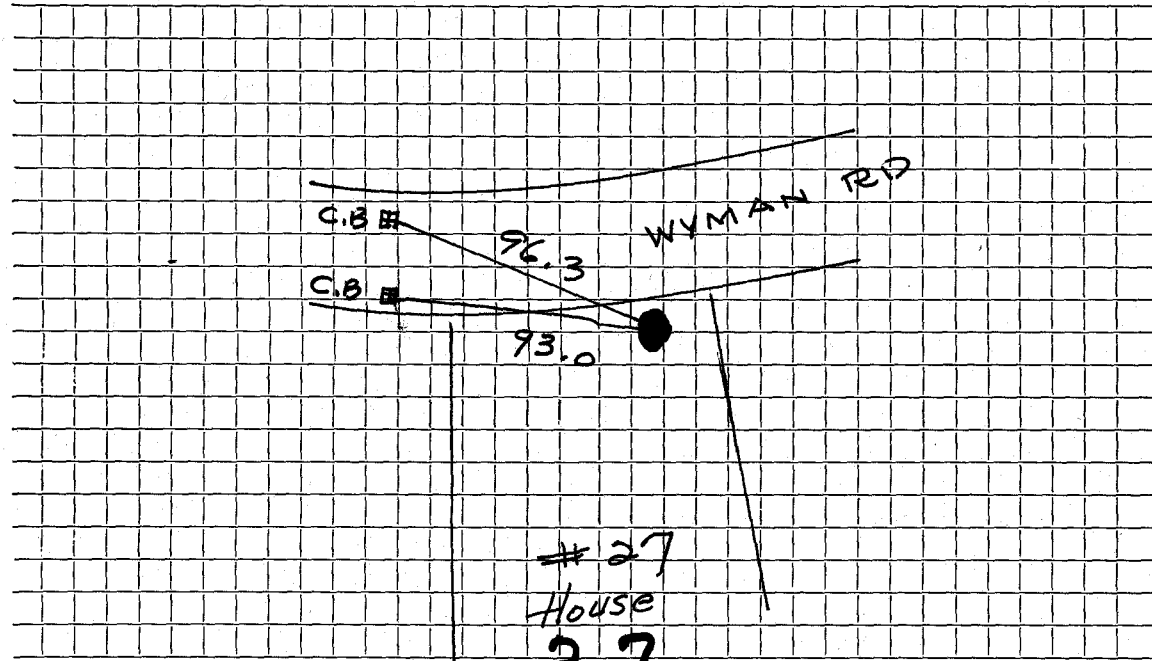

Connection made in ..... Street. Work completed .....

Remarks: .....

.....

.....