

WATER SERVICE RECORD

Name

29 28

Service No.

Address

lot ~~35~~ ~~25~~ Wyman Rd.

Location

28 Wyman Road

~~Renewal~~ New Service

SERVICE IN TO CURB

Date	Material	Amount	Total	Date	Amount
6-4-55					
	50' 3/4" Copper				
	1 3/4"C. X 1/2" I.W.H. Stop + Waste			11/12/53 Labor	3 77
				22' - 3/4" Copper tubing @ .3629	7 98
				1 - 3/4"C. corp-cock	4 33
				1 - 3/4"C. x 3/4"C. curb-cock	4 67
				1 box and rod	3 90
				1 hr. trucking	75
					25 40


NON CHARGE

DATE _____

TOWN OF LEXINGTON — BOARD OF PUBLIC WORKS

WATER DIVISION

Sketch of Service Here

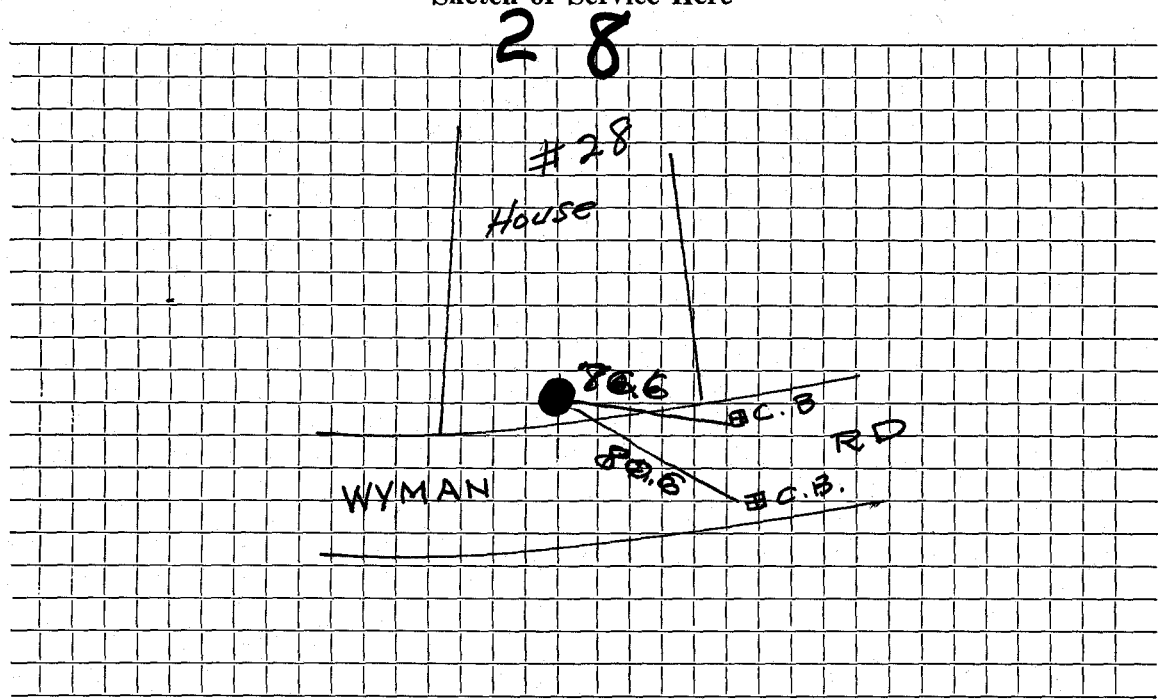

Connection made in Street. Work completed

Remarks:

.....

.....