

WATER SERVICE RECORD

Name

4 29

Service No.

Address

Lot ~~12~~ ~~13~~ Wyman Road

Location

29 Wyman Road

~~Repair~~ ~~Renewal~~ - New Service

SERVICE IN TO CURB


Date	Material	Amount	Total	Date	Amount
8-11-55					
	52' 3/4" Copper				NON CHARGE
	1 3/4" C. X 1/2" I. W. H. Stop + Waste			11/12/53 Labor	3 78
				8' - 3/4" Copper tubing @ .3629	2 90
				1 - 3/4" C. corp-cock	4 33
				1 - 3/4" C x 3/4" C. curb-cock	4 67
				1 box and rod	3 90
				1 hr. trucking	75
					20 33

DATE _____

TOWN OF LEXINGTON — BOARD OF PUBLIC WORKS

WATER DIVISION

Sketch of Service Here

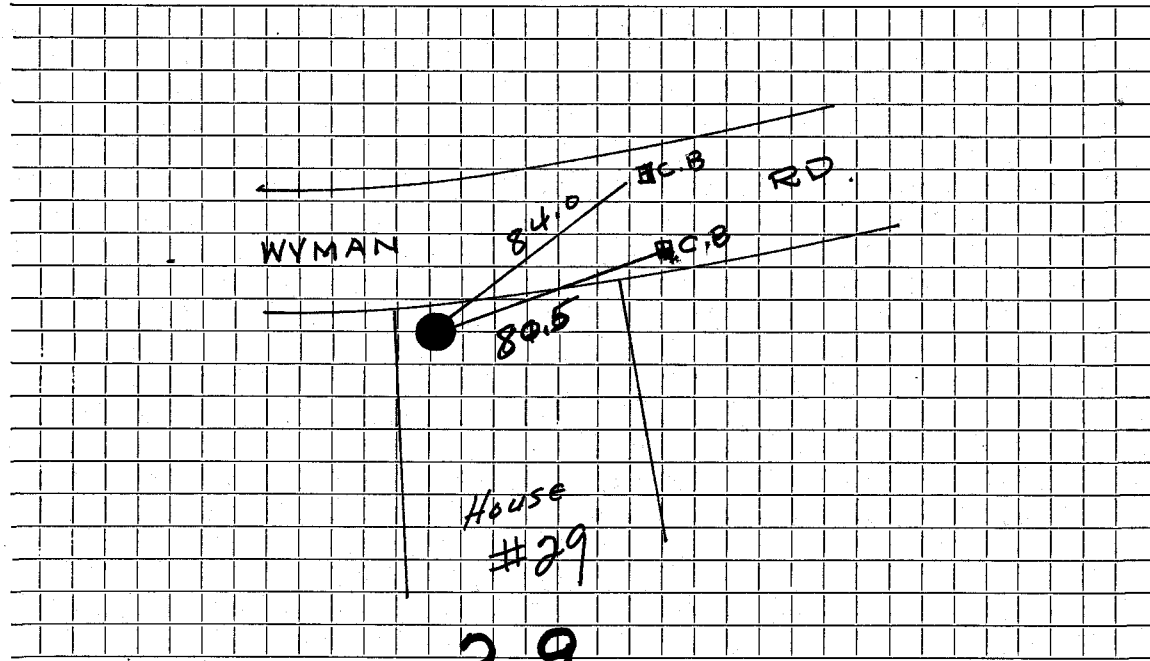

29

Connection made in Street. Work completed

Remarks:
.....
.....