

WATER SERVICE RECORD

Name 30

30

Service No.

Address ~~11~~ Wyman Rd. Lot #~~36~~

Location Lexington 30 Wyman Road

~~Repair~~ - New Service SERVICE INTO CURB


Date	Material	Amount	Total	Date	Amount
6-7-55	51' 3/4" Copper				
	1 3/4" C. X 1/2" I.W.H. Stop + Waste				
					NON CHARGE
				11/12/53 Labor	3 78
				22' - 3/4" Copper Tubing @.3629	7 98
				1-3/4" C. Corp-cock	4 33
				1-3/4" C x 3/4 C. Curb-cock	4 67
				1-3/4" C x 3/4" C. Union (3 parts)	1 72
				1-Box & Rod	3 90
				1 Hr. Trucking	75
					<u>27 13</u>

DATE _____

TOWN OF LEXINGTON — BOARD OF PUBLIC WORKS

WATER DIVISION

Sketch of Service Here

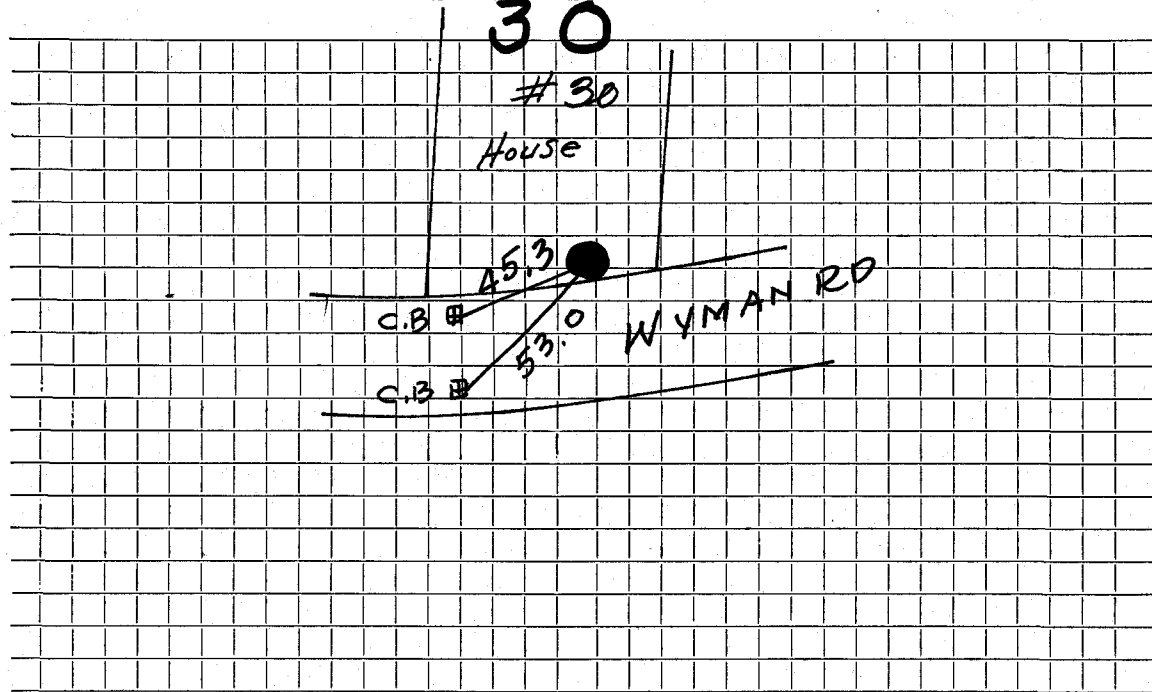

Connection made in Street. Work completed

Remarks:

.....

.....