

WATER SERVICE RECORD

Name

Service No. 1812

Address 31 Wyman Rd

Location

Repair—Renewal—New Service T.D. J. McLaughlin


Date	Material	Amount	Total	Date	Service into Curb	Amount
<u>7/6/05</u>	<u>1" Copper</u>			<u>11/12/53</u>	<u>3/4 Copper</u>	
<u>73'</u>	<u>3/4 X 1" increaser</u>			<u>8'</u>	<u>3/4 COP P</u>	
<u>1</u>	<u>buff 10 box</u>				<u>3/4 Curb STEP</u>	
<u>4/22/59</u>	<u>Tebo 3/4 c</u>					

DATE _____

TOWN OF LEXINGTON — BOARD OF PUBLIC WORKS

WATER DIVISION

Sketch of Service Here

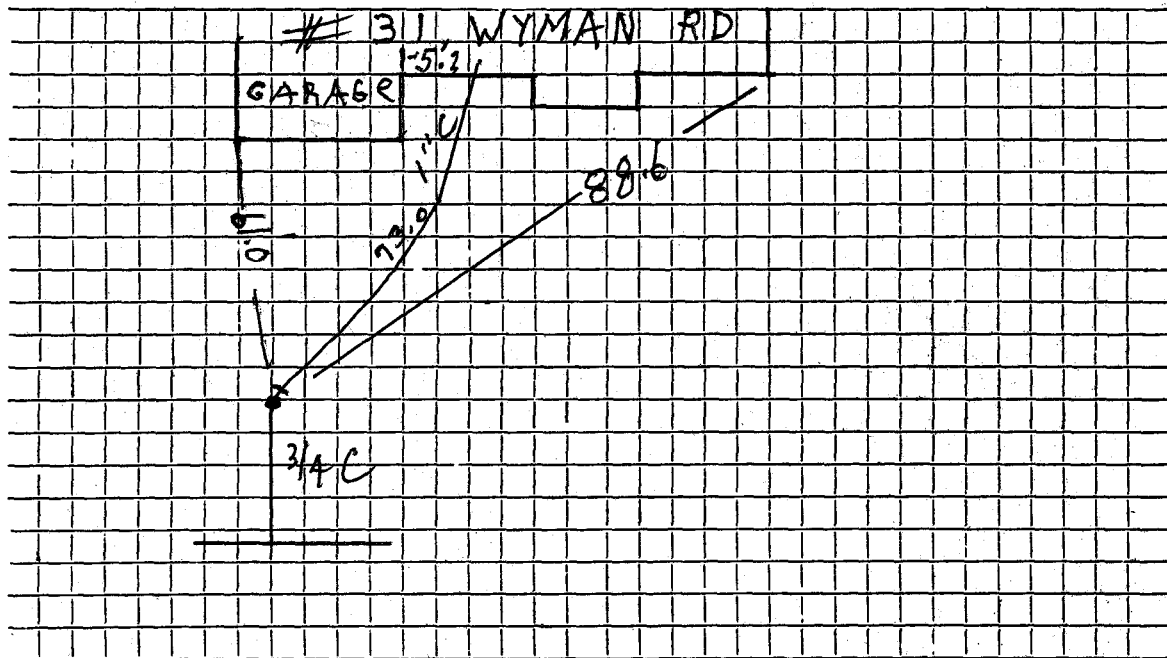

Connection made in Street.

Work completed 7/4/05 J. McLaughlin.....

Remarks:
.....
.....