

WATER SERVICE RECORD

Name 32

31

Service No.

Address Wyman Rd. Lot # 37

Location Lexington 32 Wyman Road


~~Repair~~ ~~Renewal~~ ~~New Service~~ SERVICE INTO CURB

Date	Material	Amount	Total	Date	Amount
12-16-54	49' 3/4" Copper				
	1 3/4" C. X 1/2" I.W.H. Stop+Waste				
					NON CHARGE
				11/12/53 Labor	3 78
				23'-3/4" Copper Tubing @.3629	8 35
				1-3/4" C. Corp-cock	4 33
				1-3/4" C x 3/4" C. Curb-cock	4 67
				1-3/4" C x 3/4" C. Union (3 parts)	1 72
				1-Box & Rod	3 90
				1 Hr. Trucking	75
					<u>27 50</u>

TOWN OF LEXINGTON — BOARD OF PUBLIC WORKS

WATER DIVISION

Sketch of Service Here

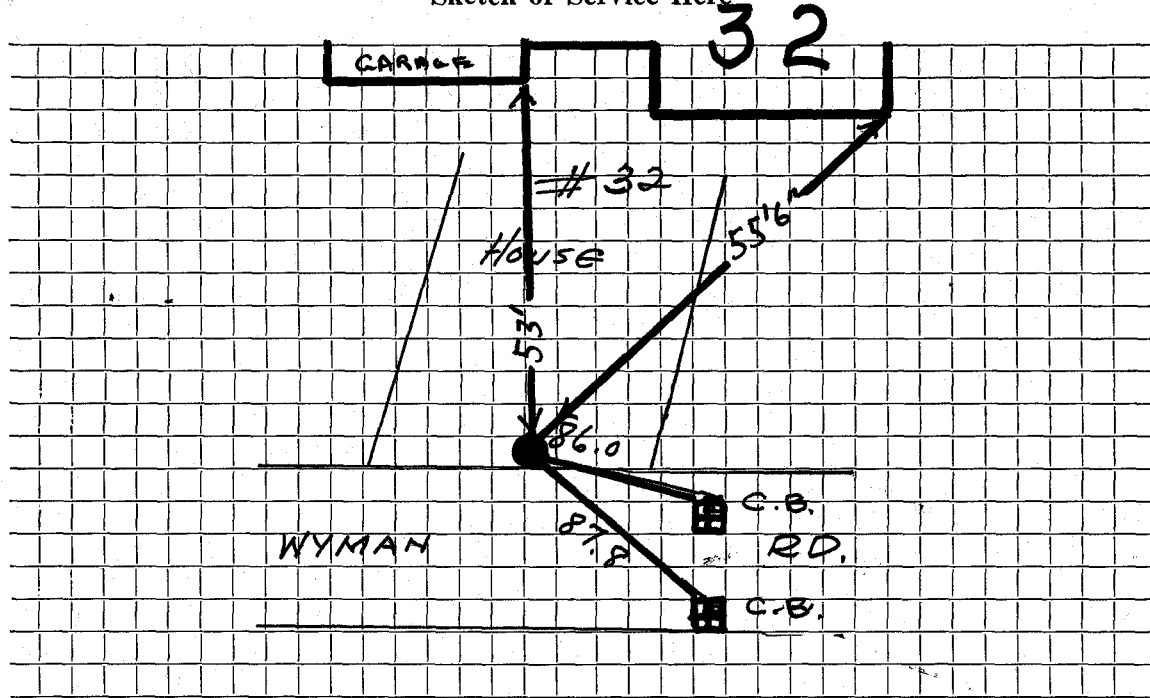

Connection made in ..... Street. Work completed .....

Remarks: .....

.....

.....