

WATER SERVICE RECORD

Name 33

2

Service No.

Address ~~8~~ Wyman Rd. Lot #10

Location Lexington **33 Wyman Road**

~~Repair/Replacement~~ — New Service

SERVICE INTO CURB


| Date | Material | Amount | Total | Date | Amount |
|---------|--------------------------------------|--------|-------|--------------------------------|--------------|
| 5-26-55 | 55' 3/4" Copper | | | | |
| | 1 3/4" C. X 1/2" I.W.H. Stop + Waste | | | | |
| | | | | | NON CHARGE |
| | | | | 11/12/53 Labor | 3 78 |
| | | | | 8' - 3/4" Copper tubing @.3629 | 2 90 |
| | | | | 1-3/4" C. Corp-cock | 4 33 |
| | | | | 1-3/4" C x 3/4" C. Curb-cock | 4 67 |
| | | | | 1-Box & Rd. | 3 90 |
| | | | | 1 Hr. Trucking | 75 |
| | | | | | <u>20 33</u> |

DATE _____

TOWN OF LEXINGTON — BOARD OF PUBLIC WORKS

WATER DIVISION

Sketch of Service Here

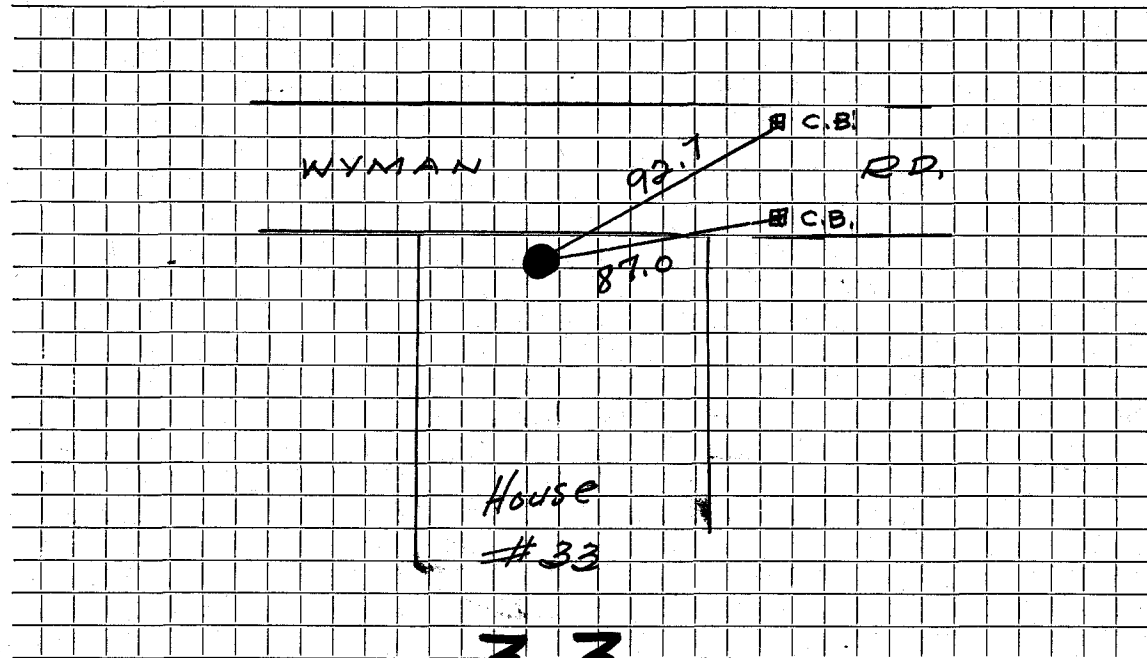

Connection made in Street. **33** Work completed

Remarks: 9.22.04 Repair made just outside foundation
2- 3pt unions - 15' 3/4" copper