

WATER SERVICE RECORD

Name 34

Service No. 2

Address Wyman Rd. Lot # 38

Location Lexington 34 Wyman Road

~~Repair~~ - New Service SERVICE INTO CURB


Date	Material	Amount	Total	Date	Amount
6-14-56	60' 3/4" Copper				
	1 3/4" C. X 1/2" I.W.H. Stop + Waste				
					NON CHARGE
				11/12/53 Labor	3 78
				23'-3/4" Copper Tubing @.3629	8 35
				1-3/4" C. Corp-cock	4 33
				1-3/4" C x 3/4" C. Curb-cock	4 67
				1-Box & Rod	3 90
				1 Hr. Trucking	<u>75</u>
					25 78

DATE _____

TOWN OF LEXINGTON — BOARD OF PUBLIC WORKS

WATER DIVISION

Sketch of Service Here

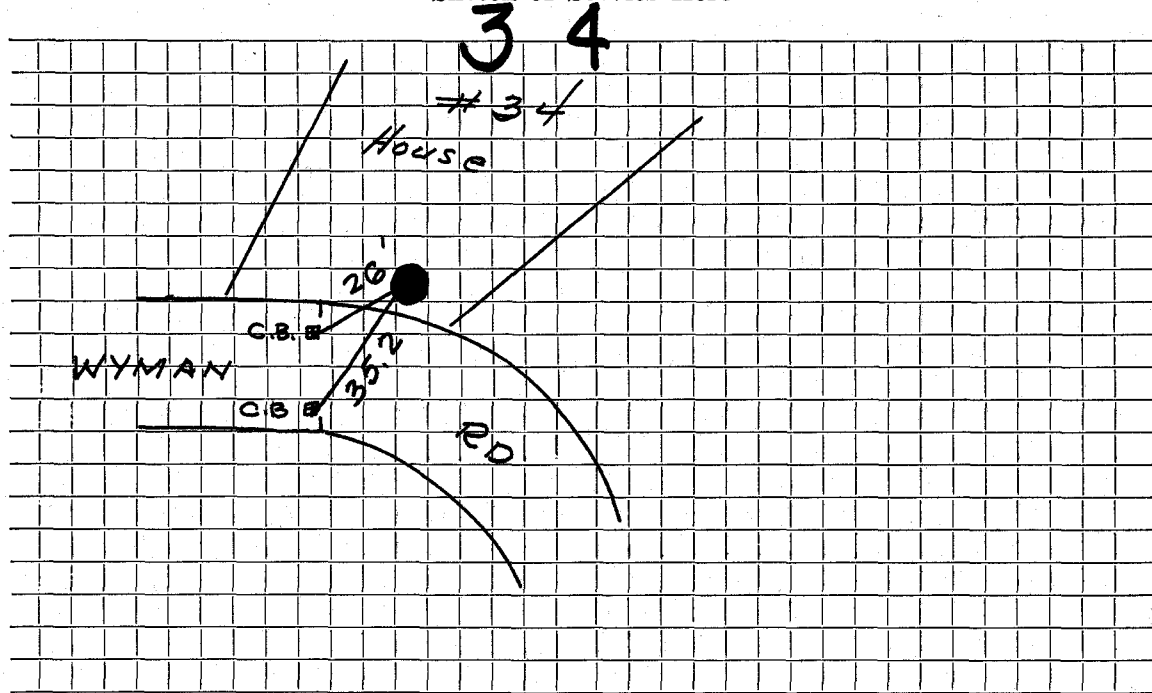

Connection made in Street. Work completed

Remarks:
.....
.....