

WATER SERVICE RECORD

Name 36

33

Service No.

Address ~~5~~ Wyman Rd. Lot # ~~39~~Location Lexington **36 Wyman Road**~~Roadwork~~ - New Service SERVICE INTO CURB


Date	Material	Amount	Total	Date	Amount
6-21-55	120' 3/4" Copper				
	1 3/4" X 1/2" I.W.H. Stop + Waste				NON CHARGE
	1 3/4" X 3/4" 3 Part Unions			11/12/53 Labor	3 78
				21'-3/4" Copper Tubing @.3629	7 62
				1-3/4" C. Corp-cock	4 33
				1-3/4" C x 3/4" C. Curb-cock	4 67
				1-Box & Rod	3 90
				1 Hr. Trucking	<u>75</u>
					25 05

DATE _____

TOWN OF LEXINGTON — BOARD OF PUBLIC WORKS

WATER DIVISION

Sketch of Service Here **36**

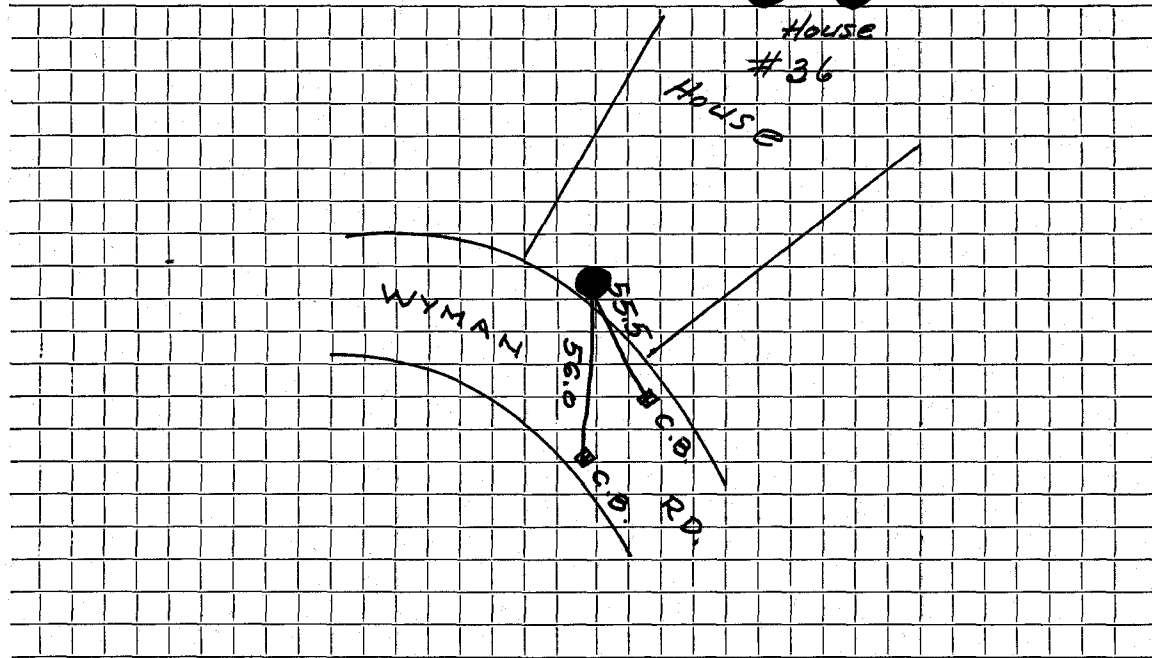

Connection made in Street. Work completed

Remarks:
.....
.....