

WATER SERVICE RECORD

Name 37

Service No.

Address Wyman Rd. Lot # 9

Location Lexington 37 Wyman Rd.

~~REPAIR WORK~~ New Service SERVICE INTO CURB


Date	Material	Amount	Total	Date	Amount
4-25-58	65' 3/4" Copper				
	1 3/4" C. x 1/2" I.W.H. Stop + Waste				NON CHARGE
	1 3/4" 3 Part UNION			11/12/53 Labor	3 78
				10'-3/4" Copper Tubing @.3629	3 63
				1-3/4" C. Corp-cock	4 33
				1-3/4" C x 3/4" C. Curb-cock	4 67
				1-Box & Rod	3 90
				1 Hr. Trucking	75
					<u>21 06</u>

DATE _____

TOWN OF LEXINGTON — BOARD OF PUBLIC WORKS

WATER DIVISION

Sketch of Service Here

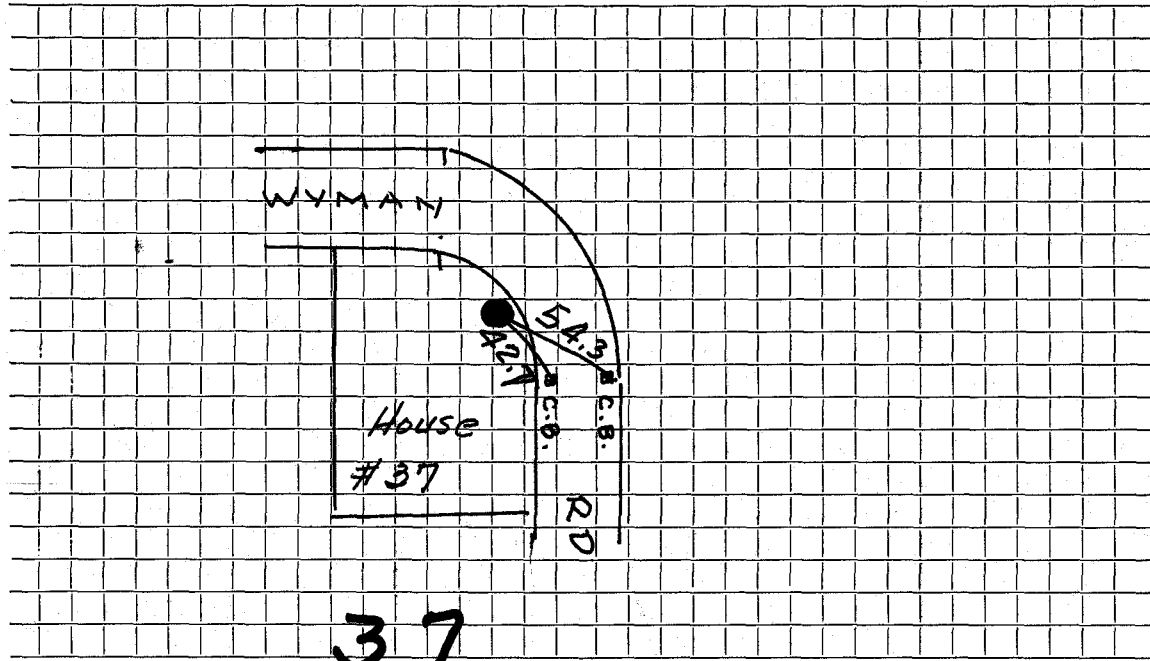

Connection made in Street. Work completed

Remarks:
.....
.....