

WATER SERVICE RECORD

Name

Service No.

Address

lot ³⁴ ~~40~~ ³⁸ ~~40~~ Wyman Road

Location

38 WYMAN ROAD

Repair - ~~Renewal~~ - New Service

SERVICE IN TO CURB

Date	Material	Amount	Total	Date	Amount
9-27-54					
	65' 3/4" Copper				NON CHARGE
	1 3/4" C. X 1/2" I.W.H. STOP + WASTE			11/12/53	Labor 3 78
	1 3/4" C. X 3/4" 3 PART UNION			22'	- 3/4" Copper tubing @ .3629 7 98
				1 -	3/4" C. corp-cock 4 33
				1 -	3/4" C x 3/4" C. curb-cock 4 67
				1 -	3/4" C x 3/4" C. Union 3 pts. 1 72
				1	box and rod 3 90
				1	hr. trucking 75
					<u>27 13</u>


DATE _____

TOWN OF LEXINGTON — BOARD OF PUBLIC WORKS

WATER DIVISION

Sketch of Service Here

38

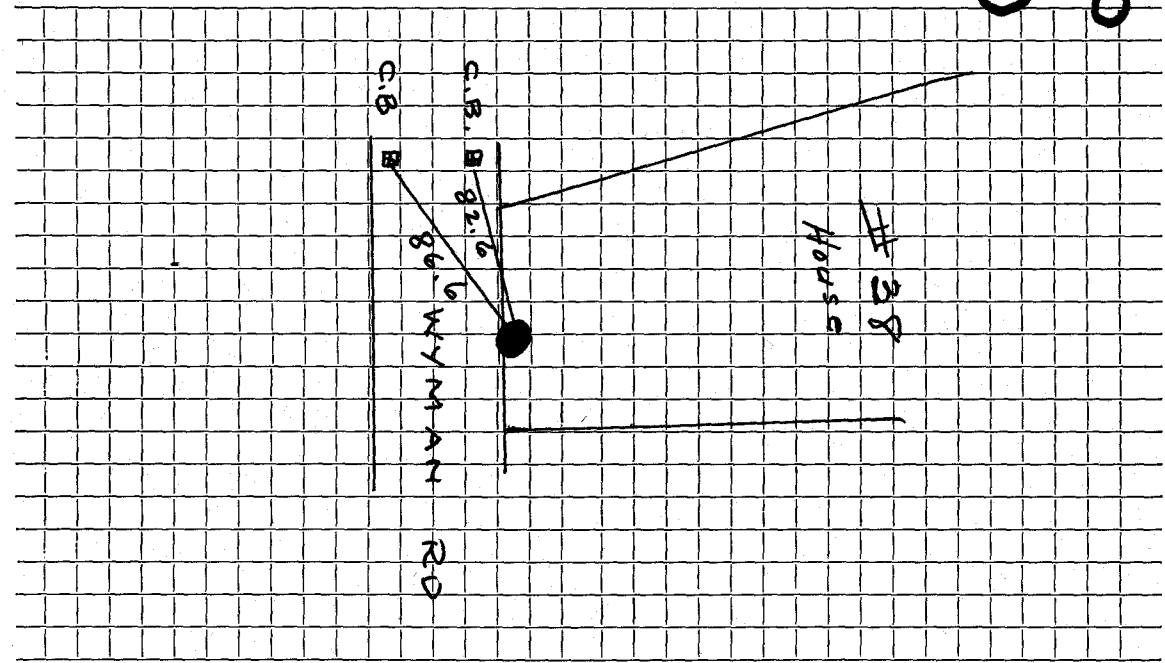

Connection made in Street. Work completed

Remarks:
.....
.....