

WATER SERVICE RECORD

Name

17 4

Service No.

Address

Lot ~~25~~ 39 Wyman Road

Location

4 Wyman Road

~~Repair~~ Renewal—New Service

SERVICE IN TO CURB


Date	Material	Amount	Total	Date	Amount
2-16-55					
	65' 3/4" Copper				NON CHARGE
	1 3/4" C. X 1/2" I.W.H. Stop + Waste			11/9/53	Labor 2 45
	1 3/4" C. UNION			23' - 3/4" Copper tubing @ .3629	8 35
				1 - 3/4" C. curb-cock	4 33
				1 - 3/4" C x 3/4" X. curb-cock	4 67
				1 - 3/4" C x 3/4" C. union 3 pts	1 72
				1 box and rod	3 90
				1 hr. trucking	75
					26 17

DATE _____

TOWN OF LEXINGTON — BOARD OF PUBLIC WORKS

WATER DIVISION

Sketch of Service Here

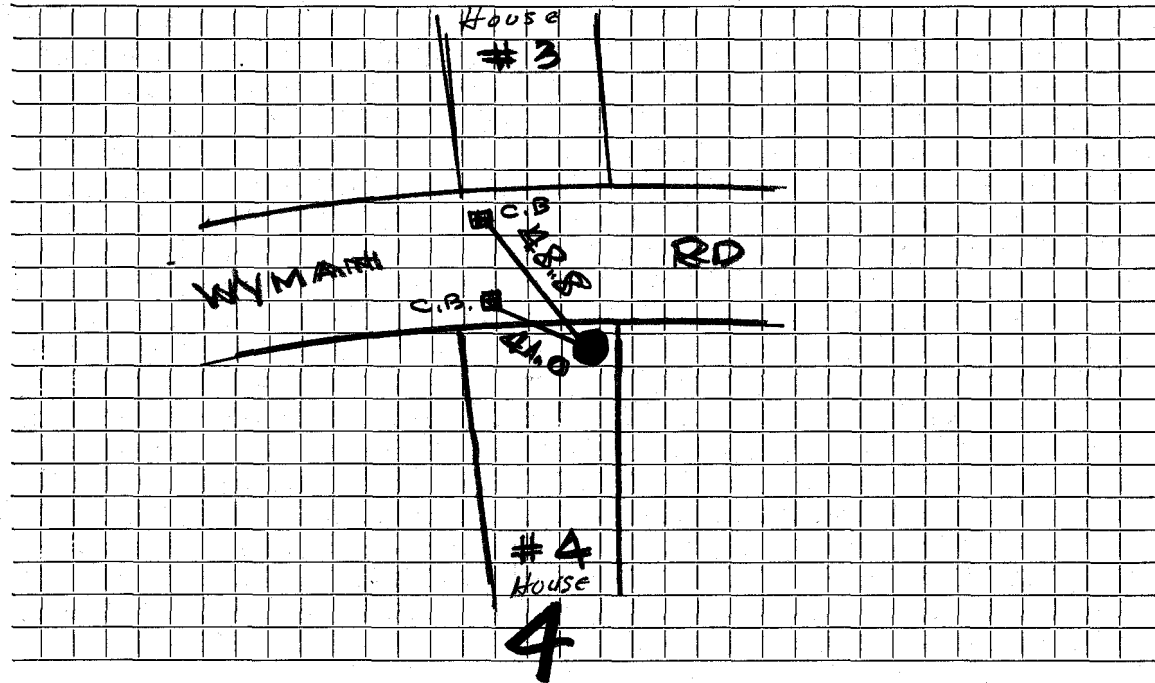

Connection made in Street. Work completed

Remarks:
.....
.....