

WATER SERVICE RECORD

Name 35 40

Service No.

Address lot 41 ~~1~~ Wyman Road

Location 40 Wyman Road

Repair-Renewal-New Service SERVICE IN TO CURB


Date	Material	Amount	Total	Date	Amount
12-14-54					
	72' 3/4" Copper				NON CHARGE
	1 3/4" C. X 1/2" I.W.H. Stop + Waste			11/12/53	Labor 3 78
	1 3/4" C. UNION				20' - 3/4" Copper tubing @ .3629 7 26
					1 - 3/4" C. corp-cock 4 33
					1 - 3/4" C x 3/4" C. curb-cock 4 67
					1 - 3/4" C x 3/4" C. Union 3 pts. 1 72
					1 box and rod 3 90
					1 hr. trucking 75
					26 41

TOWN OF LEXINGTON — BOARD OF PUBLIC WORKS

WATER DIVISION

Sketch of Service Here

40

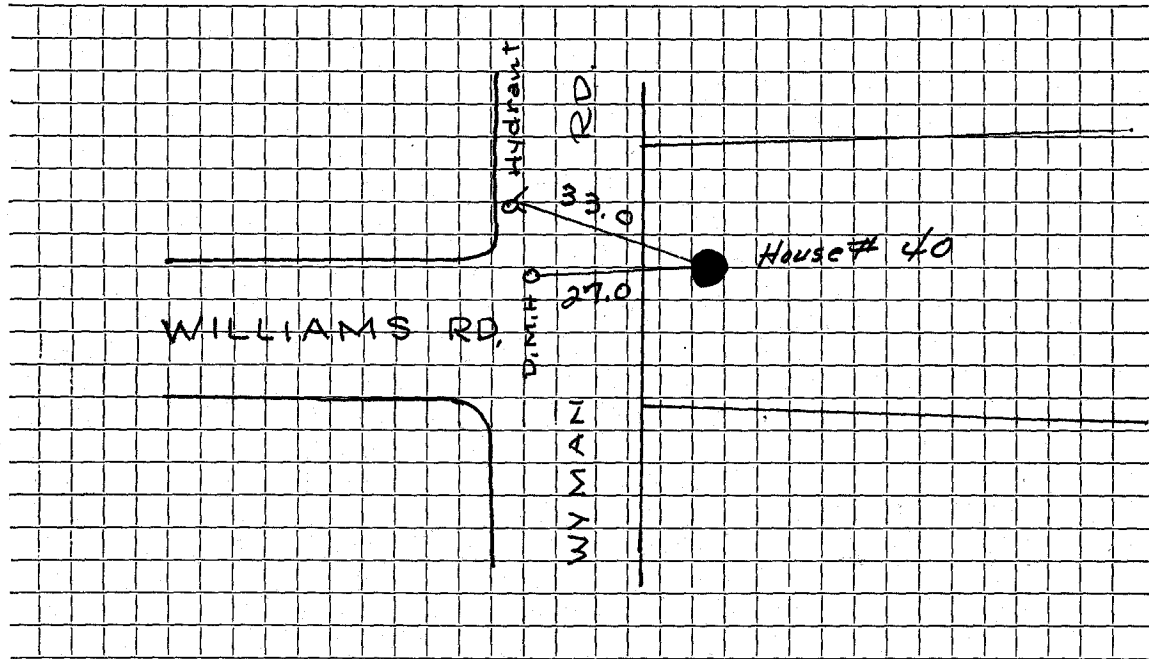

Connection made in Street. Work completed

Remarks:

.....

.....