

WATER SERVICE RECORD

Name 73

Kenney Builders, Inc.

Service No. 197

Address 1pt 21

35 Wyman Road

4558

Location 5 Wyman Road

Repair ~~Renewal~~ - New Service

SERVICE IN TO CURB:


Date	Material	Amount	Total	Date		Amount
9/24/57	labor	19 51		9-9-57	<i>Deposit</i>	\$ 100.00
9/25/57	"	7 32		11-18-57		<i>Refund</i>
		26 83			NON CHARGE	\$ 75.99
	10% overhead	2 68		11/9/53	Labor	2 46
				7' - 3/4" C	Copper tubing @ .3629	2 54
			29 51	1 - 3/4" C.	corp-cock	4 33
	68' 3/4" copper tubing @ .375		25 50	1 - 3/4" C x 3/4" C.	curb-cock	4 67
	1 3/4" C x 1/2" IWH stop & waste		4 96	1 box and rod		3 90
	1 hr. trucking @ .75		75	1 hr. trucking		75
	2 hrs. town shovel @ 6.50		13 00			18 65
	1 3/4" C3 part union		2 27			
			75 99			

DATE _____

TOWN OF LEXINGTON — BOARD OF PUBLIC WORKS

WATER DIVISION

5 Sketch of Service Here

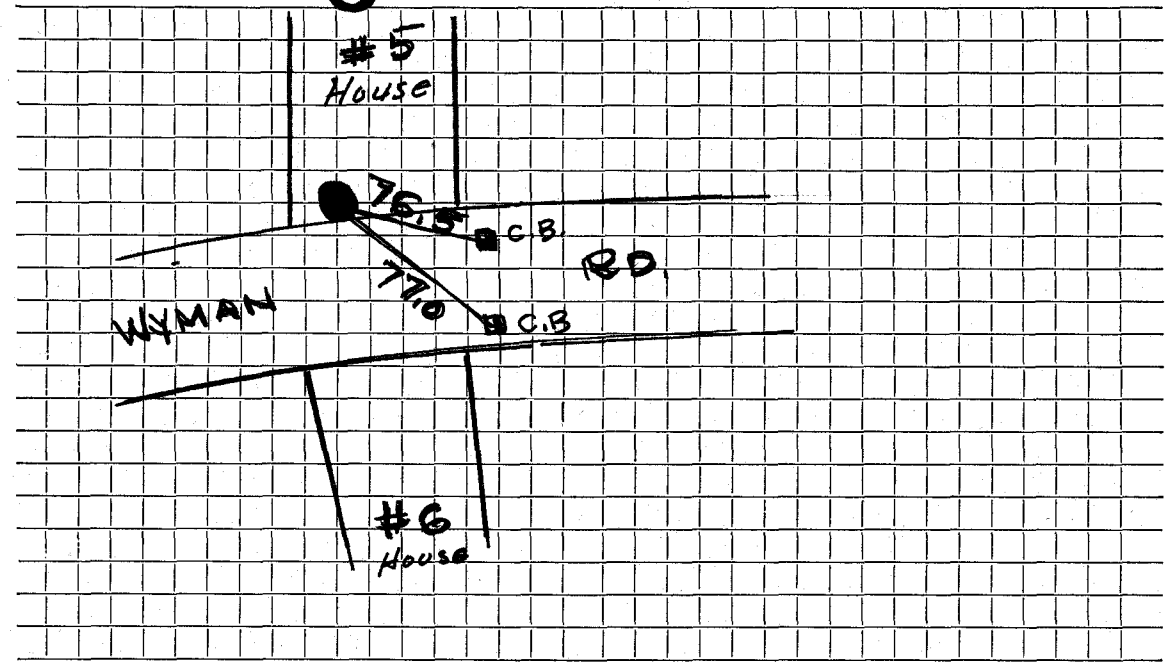

Connection made in Street. Work completed

Remarks:
.....
.....