

WATER SERVICE RECORD

Name

18 6

Service No.

Address

lot ~~24~~ ~~30~~ Wyman Road

Location

6 Wyman Road

Repair - ~~Renewal~~ - New Service

SERVICE IN TO CURB


Date	Material	Amount	Total	Date	Amount
1-10-55					
	85' 3/4" Copper				NON CHARGE
	1 3/4" X 1/2" I.W.H. Stop & Waste			11/9/53	Labor 2 45
	1 3/4" UNION			25' - 3/4" Copper tubing @ .3629	9 07
				1 - 3/4" C. corp-cock	4 33
				1 - 3/4" C x 3/4" C. curb-cock	4 67
				1 box and rod	3 90
				1 hr. trucking	75
					25 17

DATE _____

TOWN OF LEXINGTON — BOARD OF PUBLIC WORKS

WATER DIVISION

Sketch of Service Here

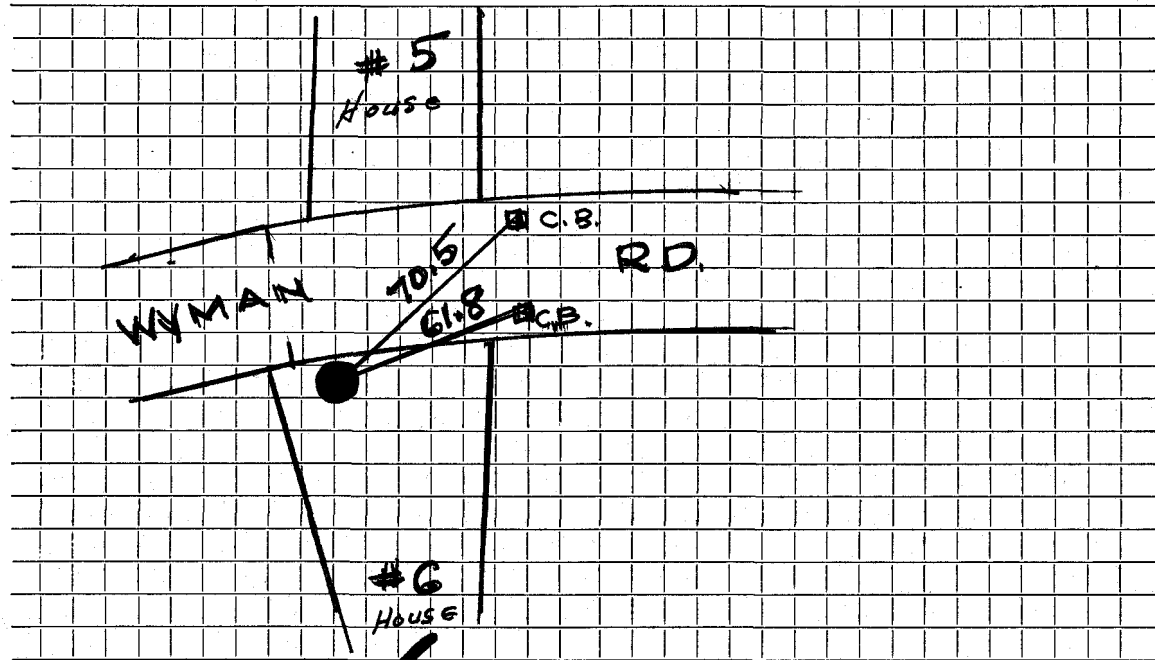

Connection made in Street. Work completed

Remarks:

.....

.....