




DATE 7/25/19

TOWN OF LEXINGTON — BOARD OF PUBLIC WORKS

WATER DIVISION

Sketch of Service Here

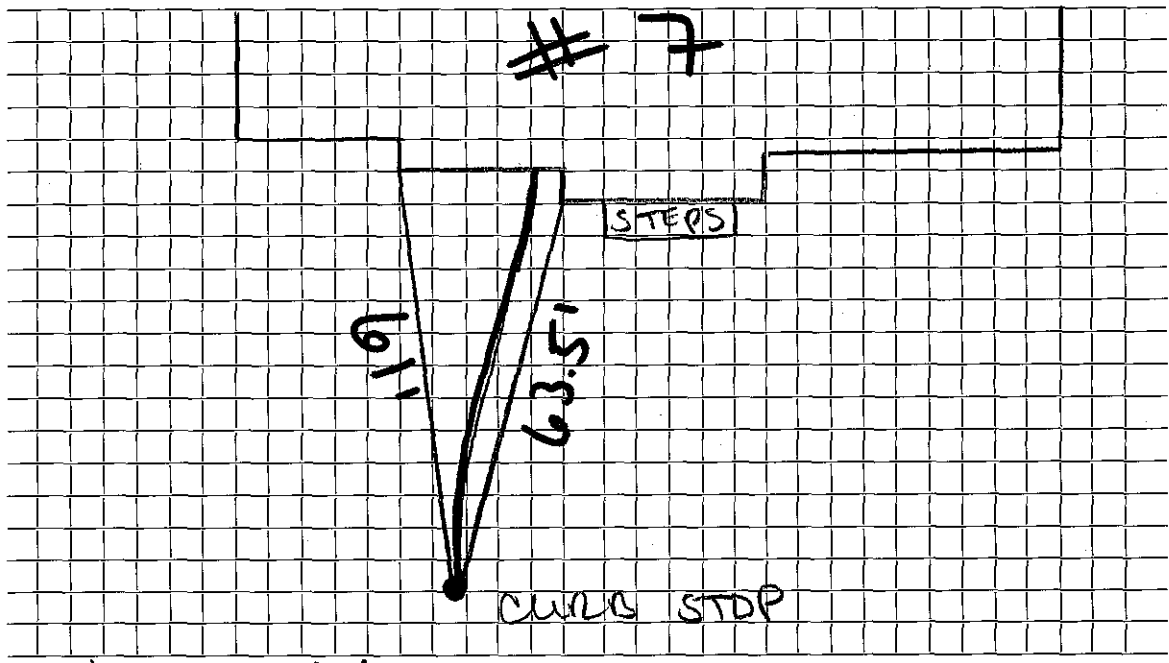

Connection made in Wyman Rd Street. Work completed .....

Remarks: .....