

WATER SERVICE RECORD

Name

79 8

Service No.

Address

lot ~~25~~ ~~35~~ Wyman Road

Location

8 Wyman Road

~~Repair-Renewal~~

New Service SERVICE IN TO CURB


Date	Material	Amount	Total	Date	Amount
12-18-54					
	40' 3/4" Copper				NON CHARGE
	1 3/4" C. X 1/2" I.W.H. Stop + Waste			11/9/53	Labor 2 46
				24' - 3/4" Copper tubing @ .3629	8 71
				1 - 3/4" C. corp-cock	4 33
				1 - 3/4" C x 3/4" C. curb-cock	4 67
				1 box and rod	3 90
				1 hr. trucking	75
					<u>24 82</u>

DATE _____

TOWN OF LEXINGTON — BOARD OF PUBLIC WORKS

WATER DIVISION

Sketch of Service Here

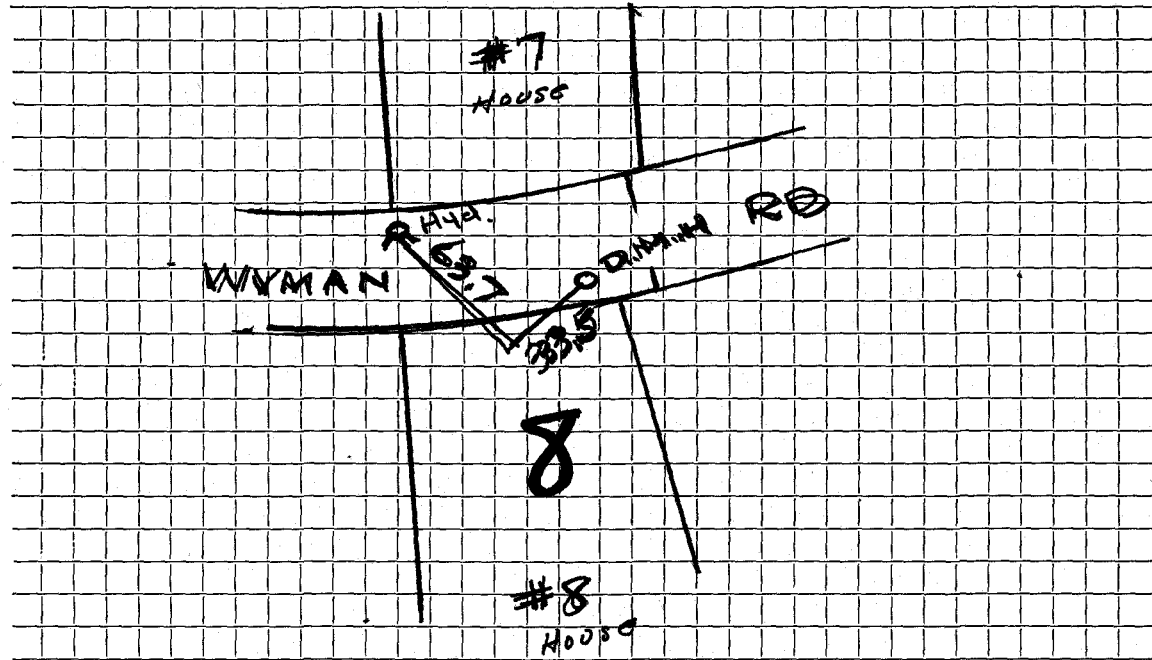

Connection made in Street. Work completed

Remarks:

.....

.....