

Name G. E. Karlson

Service No.

Address 12 York Street

Lexington, Mass.

Location 12 York Street

Kind of Pipe

Size

Size of Main

~~XXXXXXXXXX~~ New Service

Location

Date	Material	Amount	Total	Date	Amount
Sept 20 1950	58' 3/4 COPPER 3/4 x 1/2 SLW 1 3/4 3R-TUNING				
					No charge
				Sept. 30, '19	Labor 5 10
					30' - 3/4" Copper Tubing @.24 7 20
					1 - 3/4" C Corp-cock 3 15
					1 - 3/4" C x 3/4" C Curb-cock 3 85
					1 - Box & Rod 3 75
					Littlefield Shovel 2 hrs. @7.00 14 00
					Trucking 1 hr. @ .75 75
					<u>87 80</u>
	Labor				

DATE \_\_\_\_\_

TOWN OF LEXINGTON – BOARD OF PUBLIC WORKS  
**WATER DIVISION**

The undersigned applies for a supply of water at No..... St. and hereby agrees to comply with the rules and regulations as now, or at any future time, established by the Board of Selectmen.

Am't of Estimate \$.....

Owner .....


Am't Paid \$.....

Address .....

Builder .....

.....

**Sketch of Service Here**

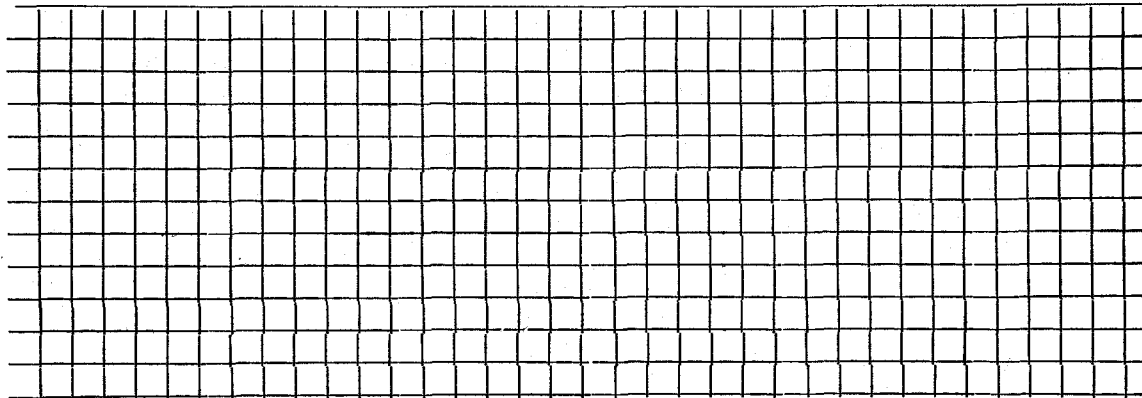

Connection made in ..... Street.

Work completed .....19

Remarks: