

## WATER SERVICE RECORD

Name W. A. Schaffer

Service No. 51

Address 27 York Street

Location

Repair ~~Renewal~~ ~~New Service~~ Work Order # 4895

MAY 9 1977


Date		Material	Amount		Total		Date	Amount
10/1/76		Labor	89	56			9-20-76	Deposit
		10% OH	8	95	98	51	5-9-77	Refund
	20'	3/4 Copper @ .65			13	00		143 80
	1	3/4 X 1/2 Reducing Bushing			1	46	10-22-76	Renewal
	1	3/4 Stop & Waste			14	53		8' 3/4" Copper
	1/2	Yd. Loam			2	25		1 3/4" C. To Lead adj mid size
	5	Lbs. Seed @ .39			1	95		1 3/4" Curb Cock
	1/2	Hr. Trucking @ 3.00			1	50		1 Box + Rod
	2	Hrs. Shovel @ 6.50			13	00		
					146	20		

DATE \_\_\_\_\_

TOWN OF LEXINGTON — BOARD OF PUBLIC WORKS

**WATER DIVISION**

Sketch of Service Here

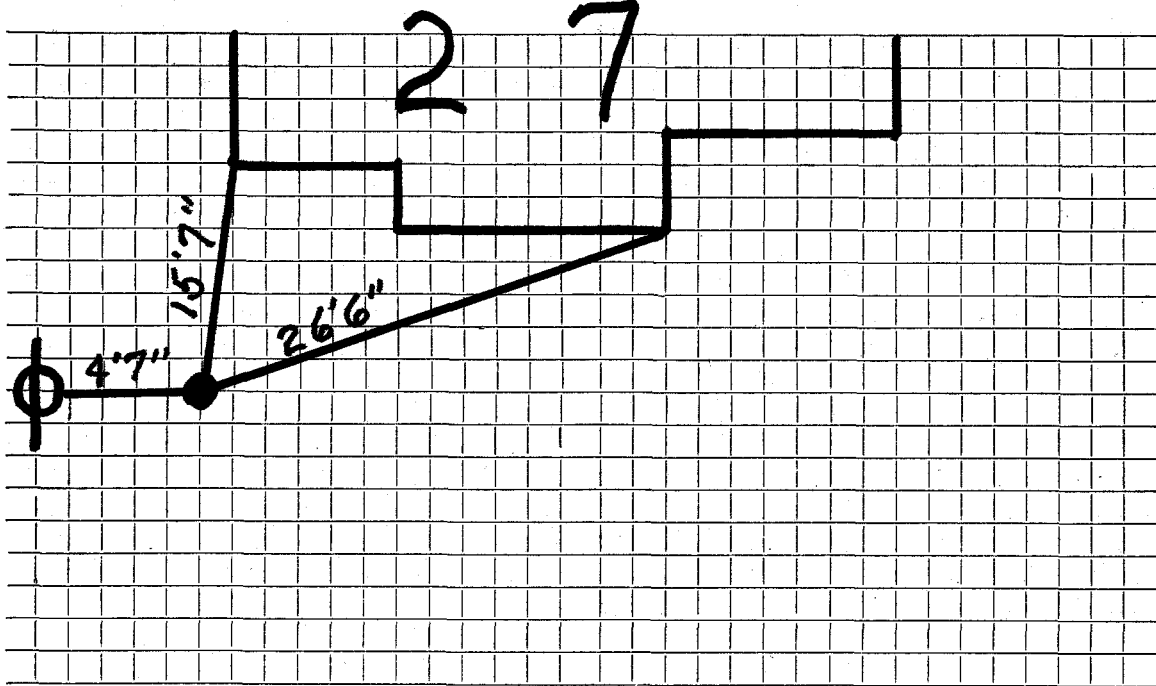

Connection made in ..... Street.      Work completed .....

Remarks: .....  
.....  
.....