

**WATER SERVICE RECORD**

Name

Service No.

Address

Location **33 York ST.**

Repair—Renewal—New Service


Date	Material	Amount	Total	Date	Amount
2-9-53	63' $\frac{3}{4}$ " Copper				
	1 $\frac{3}{4}$ " C. X $\frac{1}{2}$ " I.W.H.			12-30-52	
	STop + Waste				
				12' $\frac{3}{4}$ " Copper	
				1 $\frac{3}{4}$ " C. Adapter	
				1 $\frac{3}{4}$ " C. Curb Cock	
				1 Box + Rod	

DATE \_\_\_\_\_

TOWN OF LEXINGTON — BOARD OF PUBLIC WORKS

**WATER DIVISION**

Sketch of Service Here

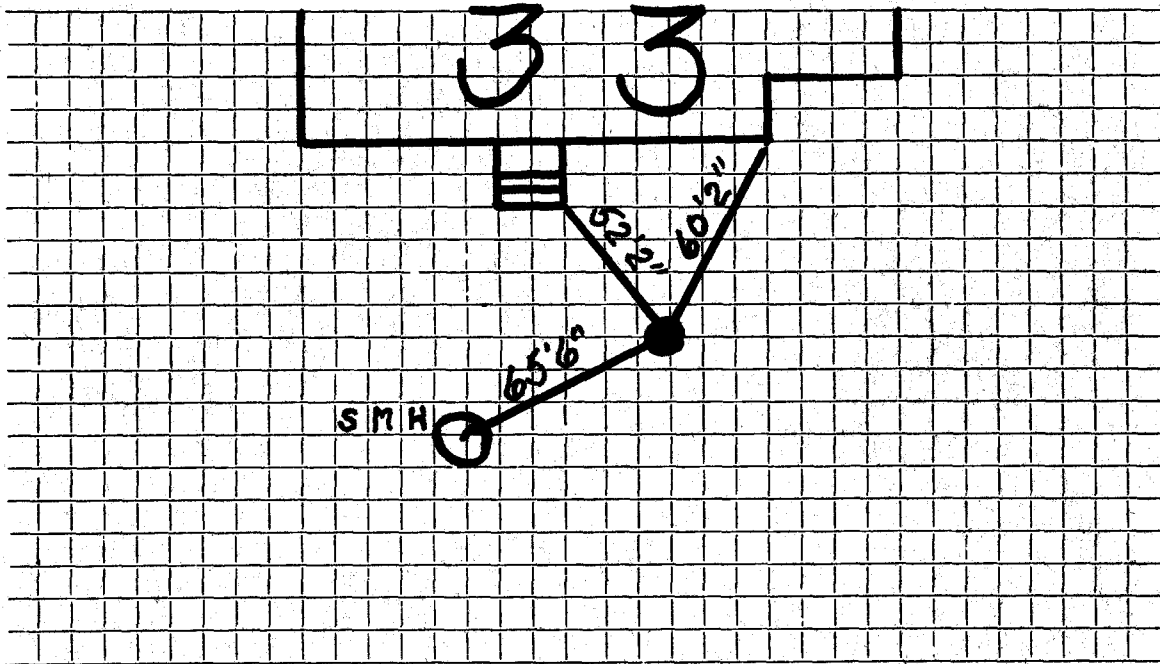

Connection made in ..... Street. Work completed .....

Remarks: *Original Service 2-9-53* .....