

Check from: Building for:

Name Ralph O. Porter, Inc. Mr. & Mrs. H. F. Sayward

Service No. ~~SE~~ 3070

Address Newton Center, Mass.

1855-1856

Location 38 York Street

Kind of Pipe *Cement lined.*

Size 1"

Size of Main

Repair—Renewal—New Service

Location

Date
1939

Material

Amount

Total

Date

Amount

August 17,

2 hrs. @ 60¢

1 20

August 8, 1939

Deposited

50 00

39' 3/4" Copper Tubing @ 20¢

7 80

September 12, 1939

Refunded

11 19

1 3/4" C. x 1/2" I S. & W.

3 75

1 3/4" C. Union (3 parts)

1 25

2 hrs. trucking @ 75¢

1 50

Trench repairs

15 56

31 06

3 75

Construction charge

34 81

Charge: 39' @ 50¢ \$19.50

Trench repairs 15.56

Const. chg. 3.75

\$38.81

Labor

Hadley Press, Inc., Lexington

TOWN OF LEXINGTON—BOARD OF PUBLIC WORKS

WATER DIVISION

The undersigned applies for a supply of water at No. 38 York St. St. and hereby agrees to comply with the rules and regulations as now, or at any future time, established by the Board of Selectmen.

Am't. of Estimate \$ _____

Owner Mr. & Mrs. H. F. Seyward


Am't. Paid \$ _____

Address _____

Builder Ralph O. Porter Inc.
825 Beacon St.
Newton Center.
Mass.

*50' or more
85' 7"
C.T. 3990*

Sketch of Service Here

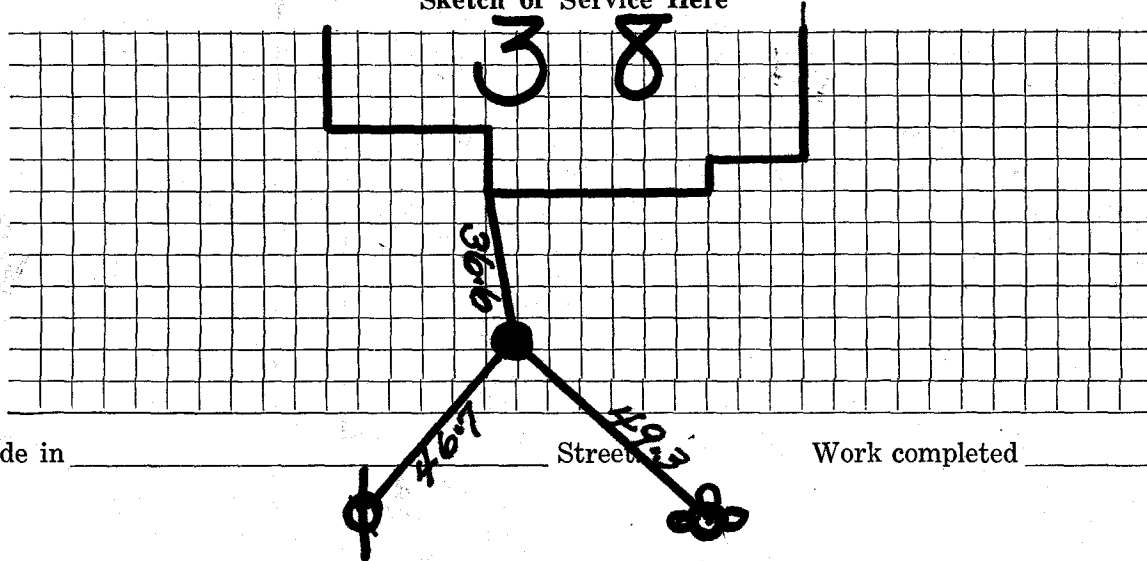

Connection made in _____

Street _____

Work completed _____

19 _____

Remarks: