

Name Clyde A. Booker

Service No. ~~3071~~

#5217

Address 12 Reed Street, Lexington

Location #39 Lot #47, York St.

Kind of Pipe

Size

Size of Main

~~Repair - Renewal~~ - New Service

Location

Date	Material	Amount	Total	Date	Amount
P. 12-31-28 for 25.00	53' 1" C.L. Pipe @.27	14 31		Jan. 5 1929 - Cash	25 -
	3 1" L.L. Coup. @.30	90			
	1 1" L.L. Ell	35			
	1 S & W	3 00			
	1 Br. Sp. Nipple	30			
	Trucking	75	19 61		
12/17/28	2 Hours Labor @.60	1 20			
	15% Overhead	18	1 38		
			20 99		
Dec. 31 1928 - Return			401		
			25 -		
	Labor				

Hart Press, Inc. Lexington

Owner to do dig. & backfilling

DATE December 5, 1928

TOWN OF LEXINGTON—BOARD OF PUBLIC WORKS

WATER DIVISION

The undersigned applies for a supply of water at No. 47^{#39} York St. St. and hereby agrees to comply with the rules and regulations as now, or at any future time, established by the Board of Selectmen.

Am't. of Estimate \$

Owner

Clyde A. Booker

Am't. Paid \$ 25-00 12/5/28


Address

12 Reed St.

Builder R W Booker Co.

Lexington Mass

Sketch of Service Here

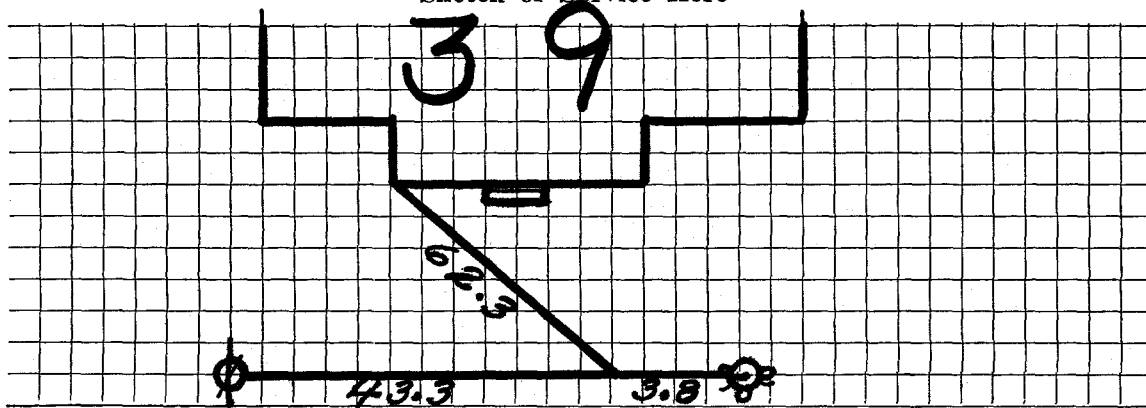

Connection made in _____ Street.

Work completed _____ 19

Remarks: