

WATER SERVICE RECORD

Name

Service No.

Address 43 York Street

Location

Repair—Renewal—New Service Valeri

Date		Material	Amount		Total		Date	Amount
6/9/87	51'	1" Copper						
		1" Valve						

Renewed

7/16/87 10'6" 1" Copper

1 1" Corp.

1 1" Curb Stop

1 Box & Rod


8 yds. Gravel

DATE _____

TOWN OF LEXINGTON — BOARD OF PUBLIC WORKS

WATER DIVISION

Sketch of Service Here

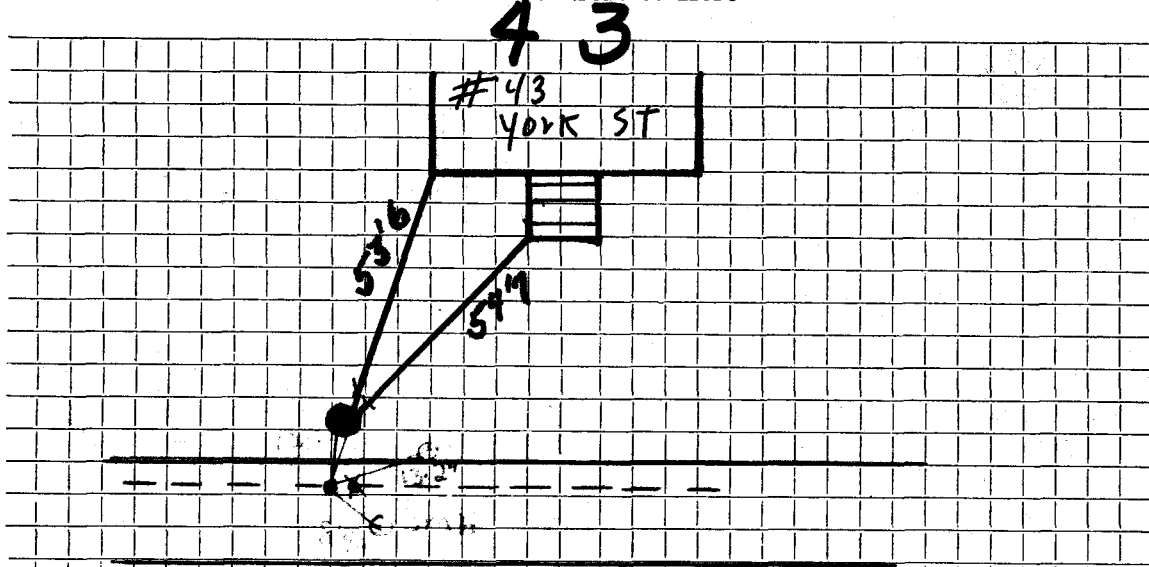

old corp 18" downhill
SIDE OF NEW TAP ONLY 3'6" DEEP

Connection made in Street. Work completed

Remarks:
.....
.....