


DATE FEB 26 1998

TOWN OF LEXINGTON — BOARD OF PUBLIC WORKS

WATER DIVISION

Sketch of Service Here

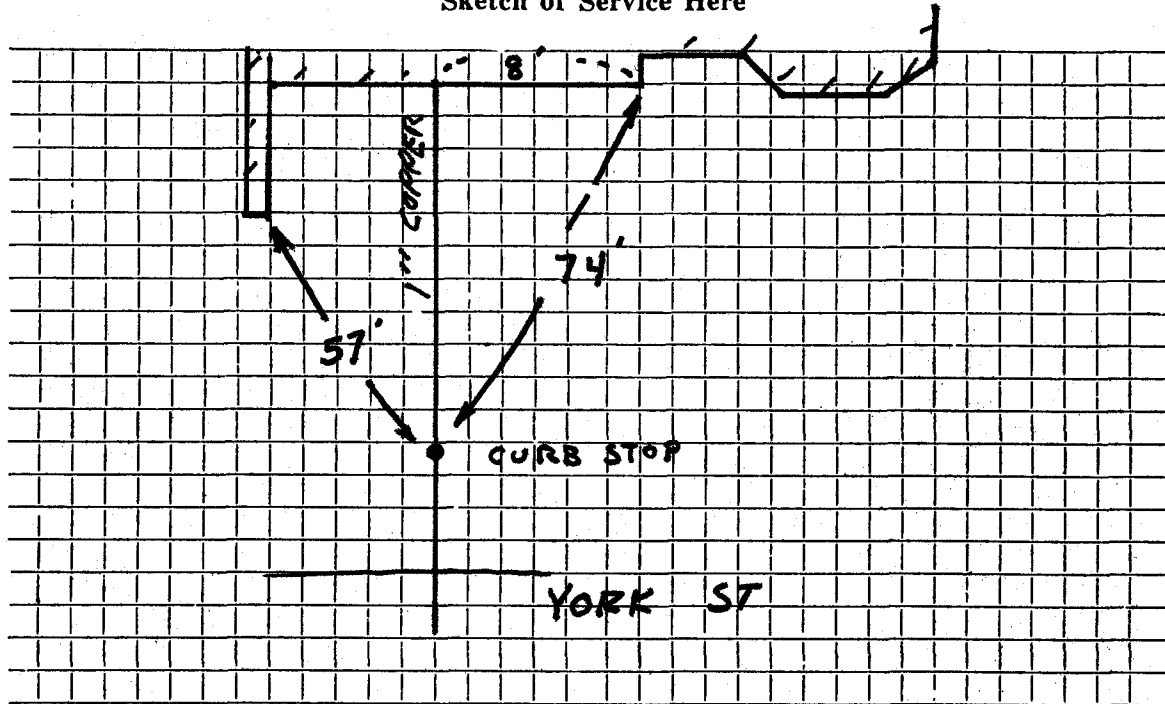

Connection made in YORK ST. Street. Work completed J.M. M.C. LAUGHLIN

Remarks:

FIELD BOOK 98-1

J.M.

Name Robert V. Baetz

Service No. 118

Address 44 York Street

Lexington, Mass.

Location 44 York Street

Kind of Pipe

Size

Size of Main

~~Repair~~ ~~Renewal~~ — New Service

Location

Date	Material	Amount	Total	Date	Location	Amount
Sept. 21, '48	Labor	4 50	4 50	Aug 12 '48	Deposited	75 00
	10% Overhead		46	Oct. 20 '48	Returned	75 00
	145' - 3/4" Copper Tubing @.255	36 98			Non-Charge	67 48
	1 - 3/4" C x 1/2" I.W.H. S & W	3 15		Aug. 25, '48	Labor	5 10
	2 - 3/4" C x 3/4" C Unions (3pts)	2 64			32' - 3.4" Copper Tubing @.255	8 16
	Trucking 1 hr. @.75		75		1 - 3/4" C Corp-cock	3 00
	Patching 19 x 3		19 00		1 - 3/4" C x 3/4" C Curb-cock	3 68
			67 48		1 - Box & Rod	3 55
					1 - 1/2" Offset Tail Piece	30
					1 - 1/2" Straight Tail Piece	30
					Littlefield Shovel 3 hrs. @7.00	21 00
					Trucking 1 hr. @.75	75
						45 84

Can. 10/25/48

trench dug by owner

Labor

Hadley Press, Inc., Lexington

