

Name Herbert Carlson

3637

Service No.

109

3338

Address 6 York Street

Location 6 York Street

Kind of Pipe

Size

Size of Main

~~WATER MAIN~~ New Service

Com 12 1-47

Location

Date	Material	Amount	Total	Date	Amount
Sept. 30, '47	Labor	1 10	1 10	Sept 4 '47	20 00
	10% Overhead		11	Dec 4 '47	2 13
	44' - 3/4" Copper Tubing @.26	11 44			17 87
	1 - 3/4" C x 1/2" I.W.H. S & W	3 15			
	1 - 3/4" C x 3/4" C U. (3 pt)	1 32		Sept. 29, '47	24 70
	Trucking 1 hr. @.75	75		Sept. 30, '47	14 40
			17 87	41' - 3/4" Copper Tubing @.26	10 66
				1 - 3/4" C Corp-cock	3 00
				1 - 3/4" C x 3/4" C Curb-cock	3 68
				1 - Box & Red	4 26
				1 - 1/2" Straight Tail Piece	50
				1 - 1/2" Offset Tail Piece	50
				Trucking 1 hr. @.75	75
	Labor				62 05

Deposited
Refunded
Non-Charge

DATE _____

TOWN OF LEXINGTON - BOARD OF PUBLIC WORKS

WATER DIVISION

The undersigned applies for a supply of water at No..... St. and hereby agrees to comply with the rules and regulations as now, or at any future time, established by the Board of Selectmen.

Am't of Estimate \$.....

Owner


Am't Paid \$.....

Address

Builder

83 East St Lex

6 Sketch of Service Here

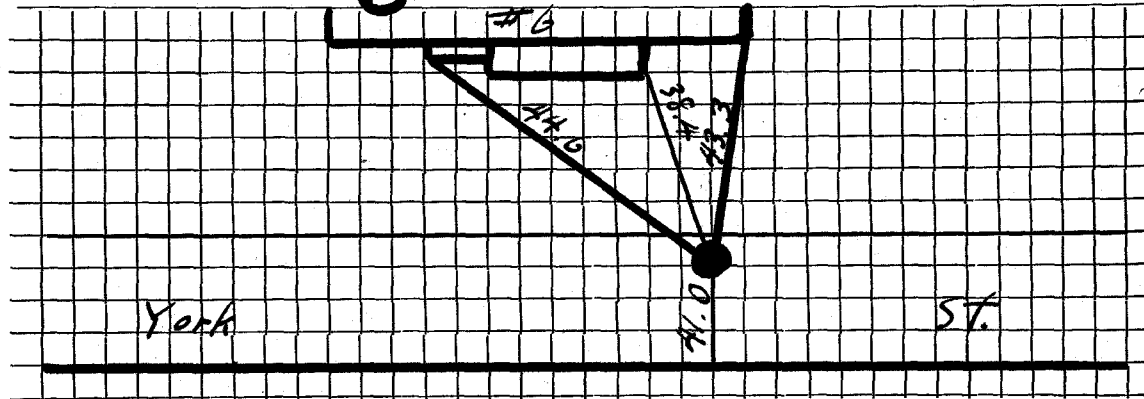

Connection made in Street.

Work completed19

Remarks: