

1000 DE 017

WATER SERVICE RECORD

Name **Ralph Frisore** Service No. **228**

Address **12 Young Street, Lexington, Mass.**

Location

~~Reason - Renamed~~ **New Service** *Comm. 12-9-57*


Date	Material	Amount	Total	Date	Amount
10-19-57	Labor	19 18		10-14-57	<i>Deposit</i> \$ 50 00
	10% overhead	1 92	21 10	12-2-57	<i>Pl. by refund on W.R. #231</i> 1 21
	48'-3/4" Copper tubing @.375	18 00		4-24-58	<i>Paid</i> 3 35
	1-3/4" C x 1/2 IWM stop & waste	4 96			<i>NON CHARGE</i>
	1 hr. Trucking @.75		75	10-19-57	Labor 4 79
	1-1/2 hr. Town Shovel @ 6.50		9 75		12'-3/4" Copper tubing @.375 4 50
			54 56		1-3/4" C Corp Cock 4 64
					1-3/4" C Curb Cock 5 94
					1 Box & Rod 4 62
					1-1/2 straight tailpiece 50
					1-1/2 offset tailpiece 50
					1/2 hr. Town Shovel @ 6.50 3 25
					1 hr. Trucking @.75 75
					<u>29 49</u>
					<i>Bill sent 12-10-57</i>
					<i>\$3.35</i>

DATE \_\_\_\_\_

# TOWN OF LEXINGTON — BOARD OF PUBLIC WORKS

## WATER DIVISION

Sketch of Service Here

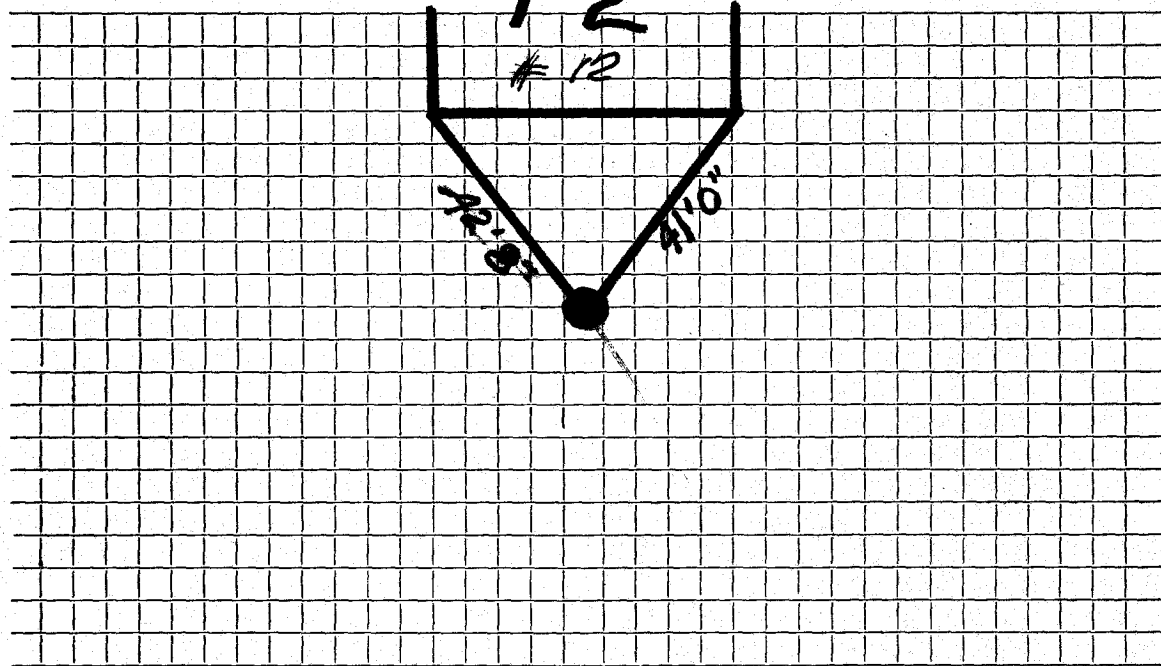

Connection made in ..... Street. Work completed .....

Remarks: .....  
.....  
.....