

WATER SERVICE RECORD

Name **Ralph Frissore** Service No. **229**
 Address **16 Young St., Lexington, Mass.**

Location

~~Repair - Remount~~ - New Service


Comm. 12-9-57

Date	Material	Amount	Total	Date	Amount
10-19-57	Labor	20 85		10-14-57	Deposit
	10% overhead	2 09	22 94	12-2-57	Pd. by refund ⁹⁷ W.H.C.# 231
	45'-3/4" Copper tubing @.375	16 88			50 00
	1-3/4" C x 1/2 IWH stop & waste	4 96			5 28
	1 hr. Trucking @.75		75		55 28
	1-1/2 hr. Town Shovel @ 6.50		9 75	10-19-57	Labor
			55 28		6 95
					NON CHARGE
					15'-3/4" Copper tubing @.375
					1-3/4" C Corp Cock
					1-3/4" C Curb Cock
					1 Box & Rod
					1-1/2 straight tailpiece
					1-1/2 offset tailpiece
					1/2 hr. Town Shovel @ 6.50
					3 25
					32 03

DATE _____

TOWN OF LEXINGTON — BOARD OF PUBLIC WORKS
WATER DIVISION

Sketch of Service Here

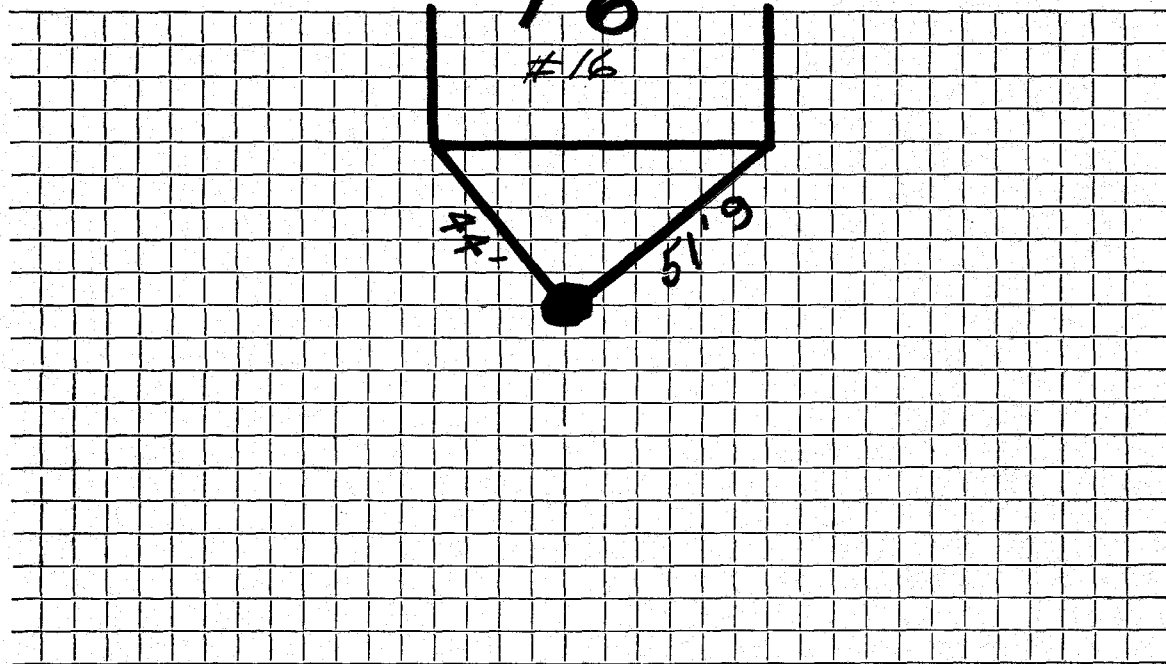

Connection made in Street. Work completed

Remarks:
.....
.....