

## WATER SERVICE RECORD

Name **Ralph Frisore** Service No. **230**  
 Address **18 Young Street, Lexington, Mass.**  
 Location  
~~Renewal~~ **New Service** Comm. **12-9-57**


Date	Material	Amount	Total	Date	Amount
10-19-57	Labor	22 24		10-14-57	Paid-Deposit \$ 50 00
	10% overhead	2 22	24 46	3-3-58	Paid 7 92
	48'-3/4" Coppertubing @.375		18 00		\$ 57 92
	1-3/4" C x 1/2 IWH stop & waste		4 96		NON CHARGE
	1 hr. Trucking @.75		75	10-19-57	Labor 5 55
	1/2 hr. Town Shovel @ 6.50		9 75	12'-3/4" Copper tubing @.375	4 50
			57 92	1-3/4" C Corp Cock	4 64
				1-3/4" C Curb Cock	5 94
				1 Box & Rod	4 62
				1 1/2 straight tailpiece	50
				1 1/2 offset tailpiece	50
				1/2 hr. Town Shovel @ 6.50	3 25
					29 51

Bill sent 12-10-57  
\$7.92

DATE \_\_\_\_\_

**TOWN OF LEXINGTON — BOARD OF PUBLIC WORKS**  
**WATER DIVISION**

Sketch of Service Here

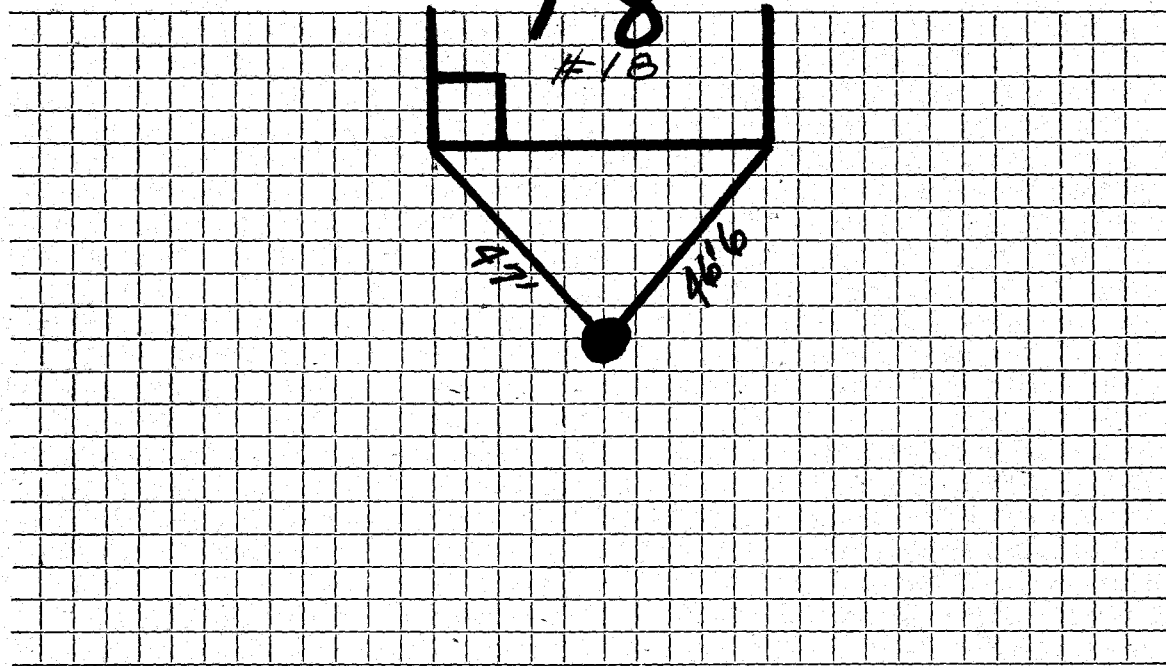

Connection made in ..... Street. Work completed .....

Remarks: .....  
.....  
.....