

WATER SERVICE RECORD

Name **Ralph Frissore**

Service No. **231**

Address

Location **20 Young Street, Lexington, Mass.**

~~Repair - Renewal~~ **New Service**

*Comm. 12-9-57*


Date	Material	Amount	Total	Date	Amount
10-21-57	Labor	16 29		10-14-57	Deposit \$ 50 00
	10% overhead	1 63	17 92	12-2-57	Returned \$ 6 49
	27'-3/4" Copper tubing @ .375	10 13			\$ 43 51
	1-3/4" C x 1/2" IWH stop & waste	4 96			NON CHARGE
	1 hr. Trucking @ .75		75	10-21-57	Labor 10 26
	1 1/2 hrs. Town Shovel @ 6.50		9 75		17'-3/4" Copper tubing @ .375 6 38
			43 51		1-3/4" C Corp Cock 4 64
					1-3/4" C Curb Cock 5 94
					1 Box & Rod 4 62
					1/2 straight tailpiece 50
					1/2 offset tailpiece 50
					1/2 hr. Town Shovel @ 6.50 3 25
					1 hr. trucking @ .75 75
					<u>56 84</u>
					\$ 65 28 applied to W.H.C. #229
					1 21 " " " #228
					\$ 6 49

DATE \_\_\_\_\_

# TOWN OF LEXINGTON — BOARD OF PUBLIC WORKS

## WATER DIVISION

Sketch of Service Here

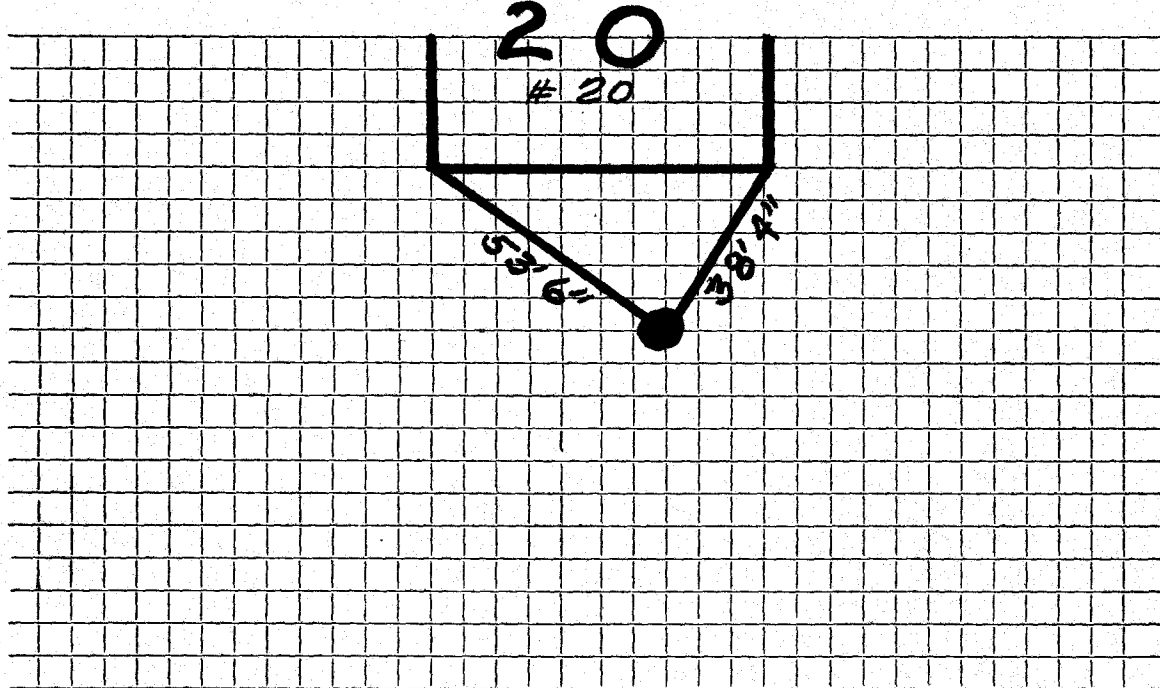

Connection made in ..... Street. Work completed .....

Remarks: .....  
.....  
.....