

WATER SERVICE RECORD

4745

Name Ralph Frissore

Service No. 157

Address 22 Young Street

Location

~~Repair~~ ~~Renewal~~ New Service

Comm. 9/30/57


Date	Material	Amount	Total	Date	Amount
8/14/57	Labor	15 40		7-31-57	Deposit \$ 75 00
	10% overhead	1 54	16 94	9-30-57	Refund 29 35
	44' - 3/4" Copper tubing @ .375		16 50		NON CHARGE \$ 11.5 6.5
	1 - 3/4" Cx 1/2 I.W.H. Stop & Waste		4 96		Labor 5 54
	1 hr. Trucking @		75		16' - 3/4" Copper tubing @ .375 6 00
	1 hr. Town Shovel @ 6.50		6 50		1 - 3/4" Corp Cock 4 64
			45 65		1 - 3/4" Curb Cock 5 94
					1 Box & Rod 4 62
					1 - 1/2 Straight tailpiece 50
					1 - 1/2 Offset tailpiece 50
					<u>27 74</u>

DATE _____

TOWN OF LEXINGTON — BOARD OF PUBLIC WORKS

WATER DIVISION

Sketch of Service Here

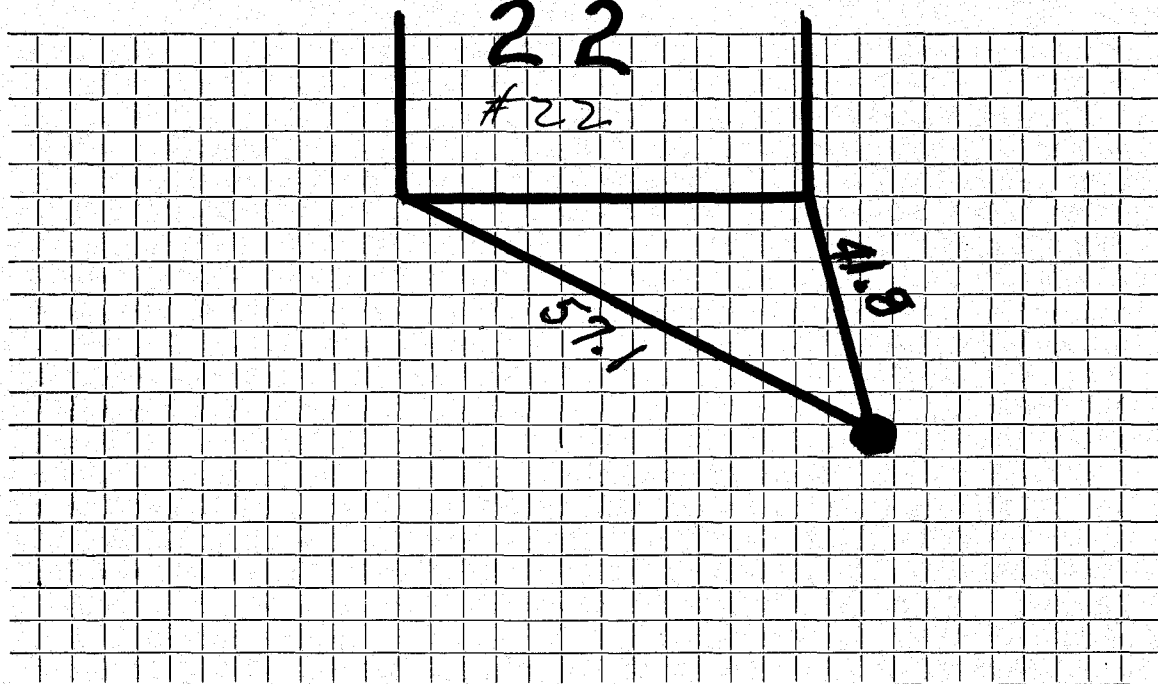

Connection made in Street. Work completed

Remarks:

.....

.....