

## WATER SERVICE RECORD

# 4822

Name Battleview Realty Trust

Service No. 22

Address 24 Young Street

Location

~~REPAIR GENERAL~~—New Service

Comm. 4/1/57

Date	Material	Amount.	Total	Date	Amount
3-14-57	Labor	2.86		3-13-57	\$ 10.00
	10 % O.H.	.29	3.15	4-1-57	1.14
	(Owner's Copper)				# 8.00
	1 3/4" C x 1/2 I.W.H. Stop & Waste		4.96		NON CHARGE
	1 hr. Trucking @.75		.75	1 1/2	Straight tail Piece .50
			8.86	1 1/2	Offset tail piece .50
					1.00


\* \$ 1.14 Applied to W.H.C. # 23

DATE \_\_\_\_\_

TOWN OF LEXINGTON — BOARD OF PUBLIC WORKS

WATER DIVISION

Sketch of Service Here

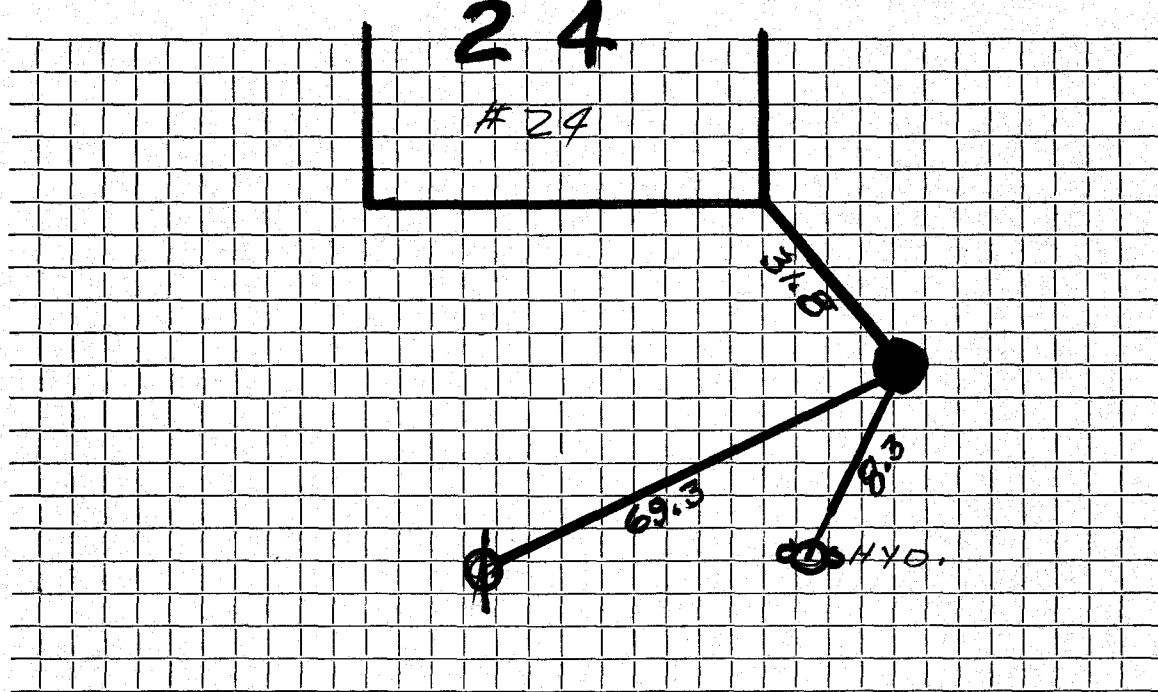

Connection made in ..... Street. Work completed .....

Remarks: .....

.....

.....