

WATER SERVICE RECORD

Name Ralph Frissore

Service No. 311 (1956)

Address 25 Young Street

Location

~~Repair~~ ~~Amount~~ - New Service

Comm. 2-25-57

Date	Material	Amount	Total	Date	Amount
10/17/56	Labor	11 80		10-11-56	Deposit \$ 75 00
	10% overhead	1 18	12 98	2/25/57	Refund 23 69
	42' - 3/4" Copper tubing @ .4396	18 46	18 46		NON CHARGE # 51 31
	1 - 3/4Cx $\frac{1}{2}$ I.W.H. Stop & Waste		4 96		Labor 3 80
	1 2/3 hrs. Littlefield Shovel				23' - 3/4" Copper tubing @ .4396 10 11
	@ 8.50		14 16		1 - 3/4" C. Corp Cock 4 64
	1 hr. trucking		75		1 - 3/4" C. Curb Cock 5 94
			51 31		1 Box & Rod 4 62
					1 - $\frac{1}{2}$ Straight tailpiece 50
					1 - $\frac{1}{2}$ Offset tailpiece 50
					1/3 hrs. Littlefield Shovel @ 8.50 2 83
					32 94


DATE _____

TOWN OF LEXINGTON — BOARD OF PUBLIC WORKS

WATER DIVISION

Sketch of Service Here

25

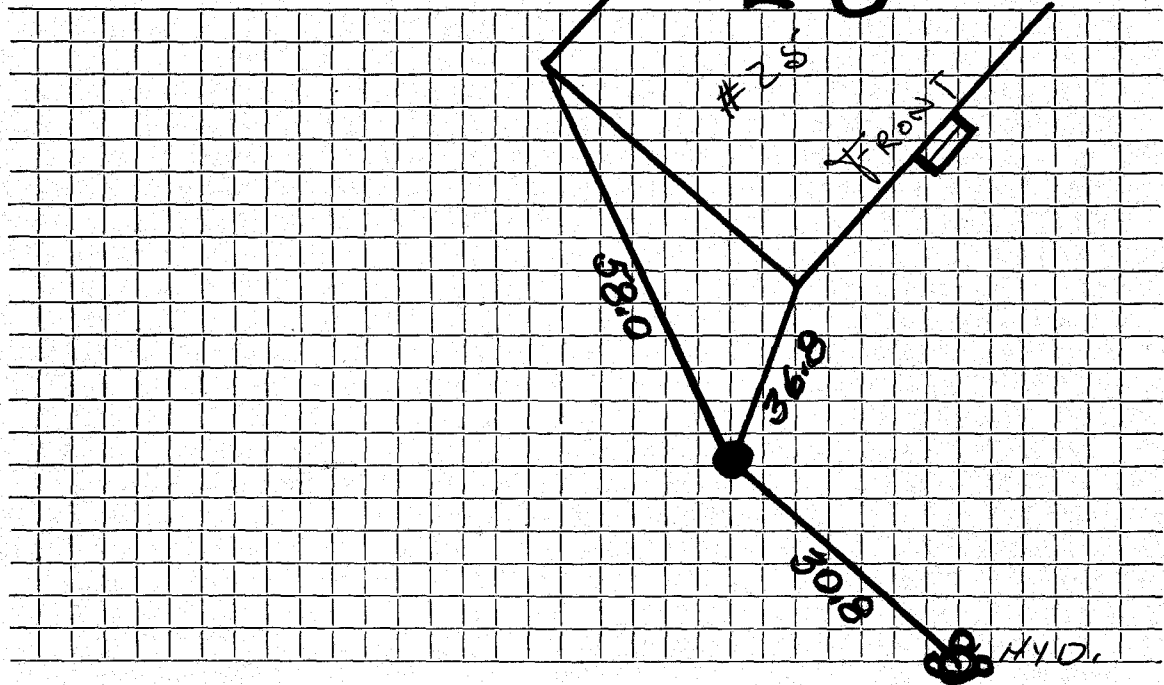

Connection made in Street. Work completed

Remarks:
.....
.....