

WATER SERVICE RECORD

Service No.

Name

Address 26 Young Street

Location

~~Repair~~ ~~Renewal~~ - New Service


Date	Material	Amount	Total	Date	Amount
3-14-57	Owners Copper 1 3/4" C. X 1/2" I.W.H. Stop & Waste				
					<u>NON CHARGE</u>
				11/2/56 Labor	1 90
				16' 3/4" Copper tubing @.4396	7 03
				1 3/4" C Corp Cock	4 64
				1 3/4" C Curb Cock	5 94
				1 Box & Rod	4 62
				1 1/2 Straight tail piece	50
				1 1/2 Offset tail piece	50
				1 Hr. trucking @.75	75
					25 88

DATE _____

TOWN OF LEXINGTON — BOARD OF PUBLIC WORKS

WATER DIVISION

Sketch of Service Here

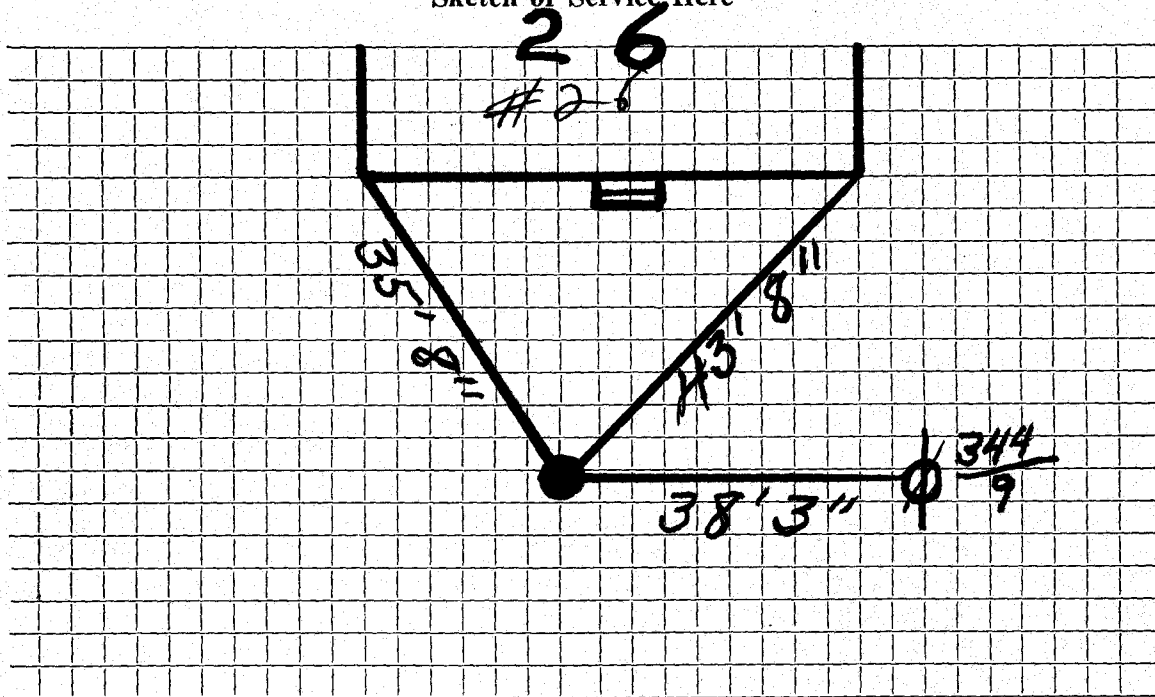

Connection made in Street. Work completed

Remarks:

.....

.....