

WATER SERVICE RECORD

Name C. J. Eliades

Service No. 57

Address 3 Young St.

Location 3 Young Street

Repair—Renewal—New Service DeFlice Bros. # 2420

APR 8 1974


Date		Material	Amount	Total	Date	Amount
1973		Copper Tubing		57 11	11-6-73	Deposit
11-5-	73	41' - 3/4" Copper				57 11
					7-28-61	
					18' 3/4" Copper	
					1 3/4" Corp Cock	
					1 3/4" Curb Cock	
					1 Box + Rod	

DATE _____

TOWN OF LEXINGTON — BOARD OF PUBLIC WORKS

WATER DIVISION

Sketch of Service Here

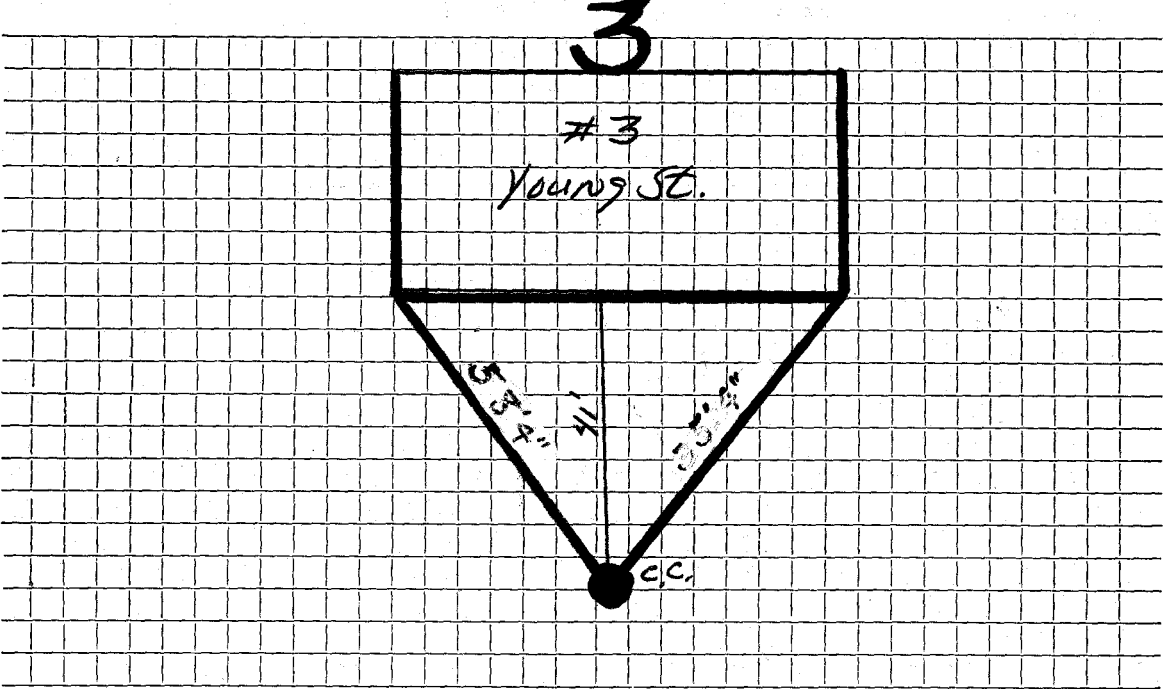

Connection made in Street. Work completed

Remarks:
.....
.....