

WATER SERVICE RECORD

Name **Ralph Frissore**

Service No. **331**

Address **30 Young Street**

Location


~~Remarks~~ **Renewal—New Service**

*Comm. 11-19-56*

Date	Material	Amount	Total	Date	Amount
11/2/56	Labor	1 90		10-30-56	Deposit 75 00
	10% overhead	20	2 10	11-19-56	Refund 46 82
	42' - 3/4" Copper tubing @ .4850	20 37			NON CHARGE 28 18
	1 - 3/4" Cx 1/2 I.W.H. Stop & Waste	4 96		11/2/56	Labor 1 90
	1 hr. trucking		75	9' - 3/4" Copper tubing @ .4850	4 37
			28 18	1 - 3/4" C. Corp Cock	4 64
				1 - 3/4" C. Curb Cock	5 94
				1 Box & Rod	4 62
				1 - 1/2 Straight tailpiece	50
				1 - 1/2 Offset tailpiece	50
					<u>22 47</u>

TOWN OF LEXINGTON — BOARD OF PUBLIC WORKS  
WATER DIVISION

Sketch of Service Here

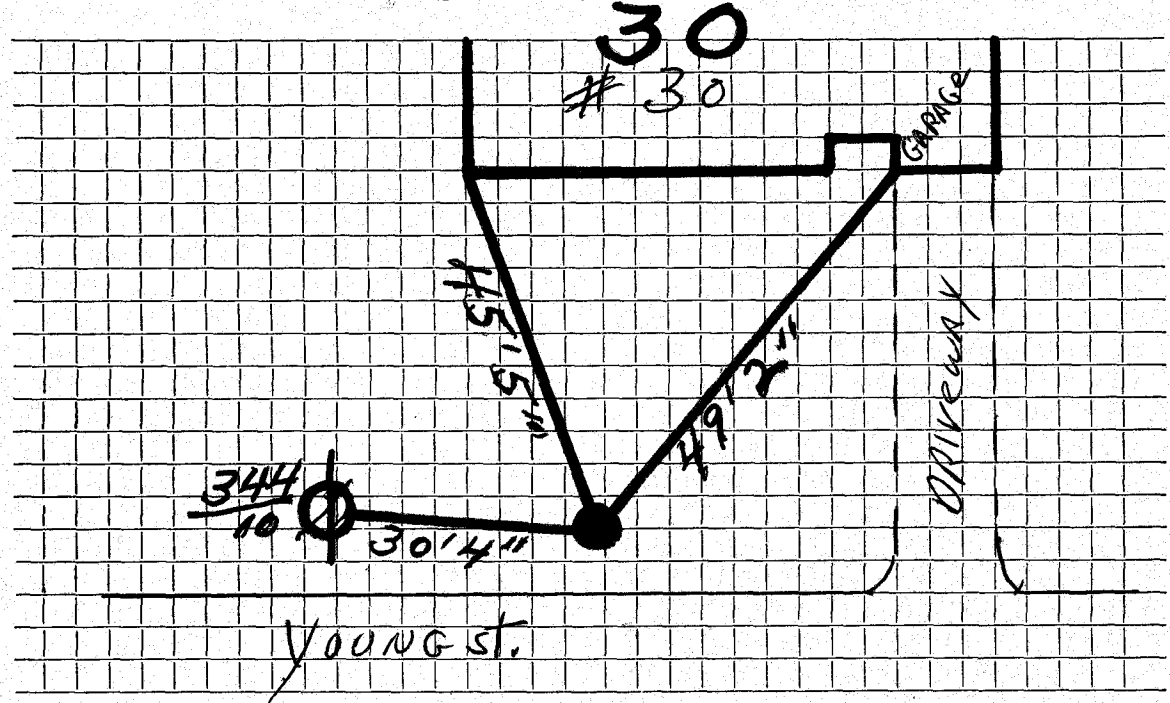

Connection made in ..... Street. Work completed .....

Remarks: .....  
.....  
.....