

WATER SERVICE RECORD

Name Battleview Park Realty Trust

Service No. 277

Address 31 Young Street

Location

~~Rapid x Rate x New Service~~


Comm. 12-3-56

Date	Material	Amount	Total	Date	Amount
10/5/56	Labor	20 18		9-27-56	Deposit 75 00
	10% overhead	2 02	22 20	12-3-56	Refund 15 53
	40' - 3/4" Copper tubing @ .4850	19 40			NON CHARGE 59 47
	1 - 3/4" C x 1/2" I.W.H. Stop & Waste	4 96	10/5/56	Labor	6 00
	1 hr. trucking		75	12' - 3/4" Copper tubing @ .4850	5 82
	1 2/3 hrs. Town Shovel @ 6.50	12 16	59 47	1 - 3/4" C. Corp Cock	4 64
				1 - 3/4" C. Curb Cock	5 94
				1 Box & Rod	4 62
				1 - 1/2" Straight tailpiece	50
				1 - 1/2" Offset tailpiece	50
				1 hr. Town Shovel	6 50
				1 hr. trucking	75
					<u>35 27</u>

DATE _____

TOWN OF LEXINGTON — BOARD OF PUBLIC WORKS
WATER DIVISION

Sketch of Service Here

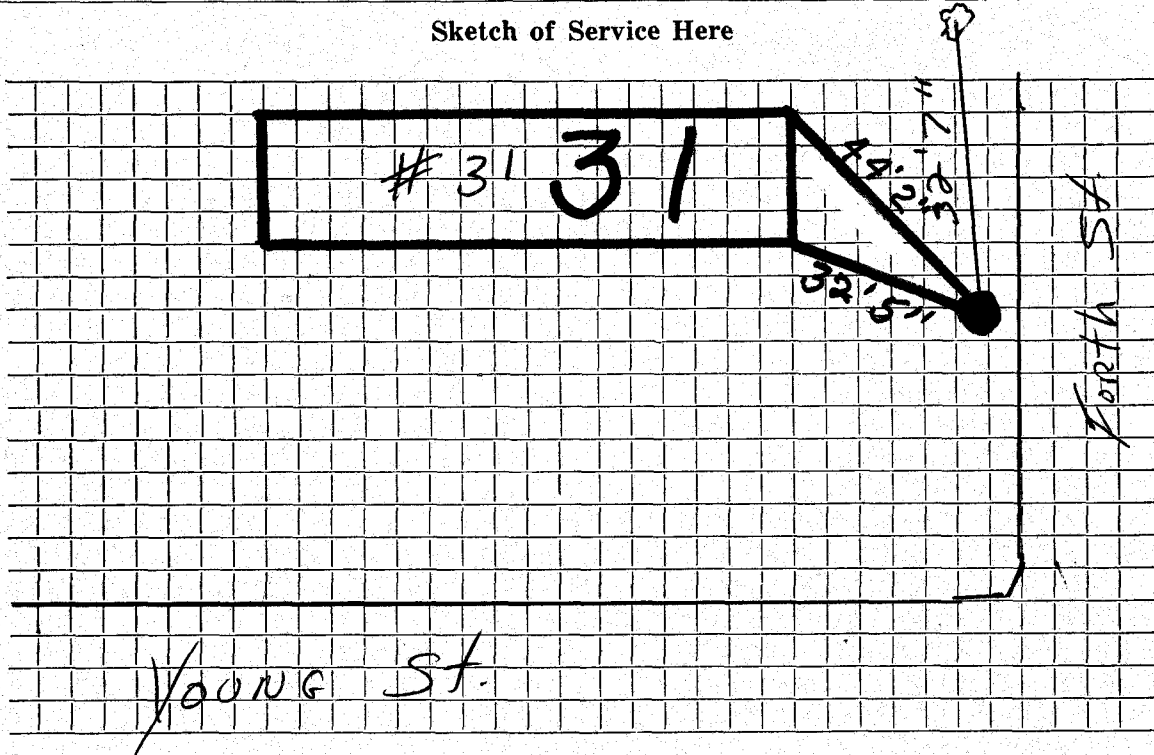

Connection made in Street. Work completed

Remarks:

.....

.....