

## WATER SERVICE RECORD

# 3652

Name Battleview Park Realty Trust

Service No. 302

Address 32 Young Street

Location

~~Repair-Renewal~~ - New Service

Comm. 12-3-56


Date	Material	Amount	Total	Date	Amount	
10/5/56	Labor	21 27		9-27-56	Deposit	\$ 75 00
	10% overhead	2 13	23 40	12-3-56	Refund	12 03
	43' - 3/4" Copper tubing @ .4850	20 86			NON CHARGE	62 97
	1 - 3/4" Cx 1/2 I.W.H. Stop & Waste	4 96		10/5/56	Labor	4 90
	1 hr. trucking		75		10' - 3/4" Copper tubing @ .4850	4 85
	2 hrs. Town Shovel @ 6.50		13 00		1 - 3/4" C. Corp Cock	4 64
			62 97		1 - 3/4" C. Curb Cock	5 94
					1 Box & Rod	4 62
					1 - 1/2" Straight tailpiece	50
					1 - 1/2" Offset tailpiece	50
					1 hr. Town Shovel @ 6.50	6 50
					1 hr. trucking	75
						26 70

DATE \_\_\_\_\_

TOWN OF LEXINGTON — BOARD OF PUBLIC WORKS

WATER DIVISION

Sketch of Service Here

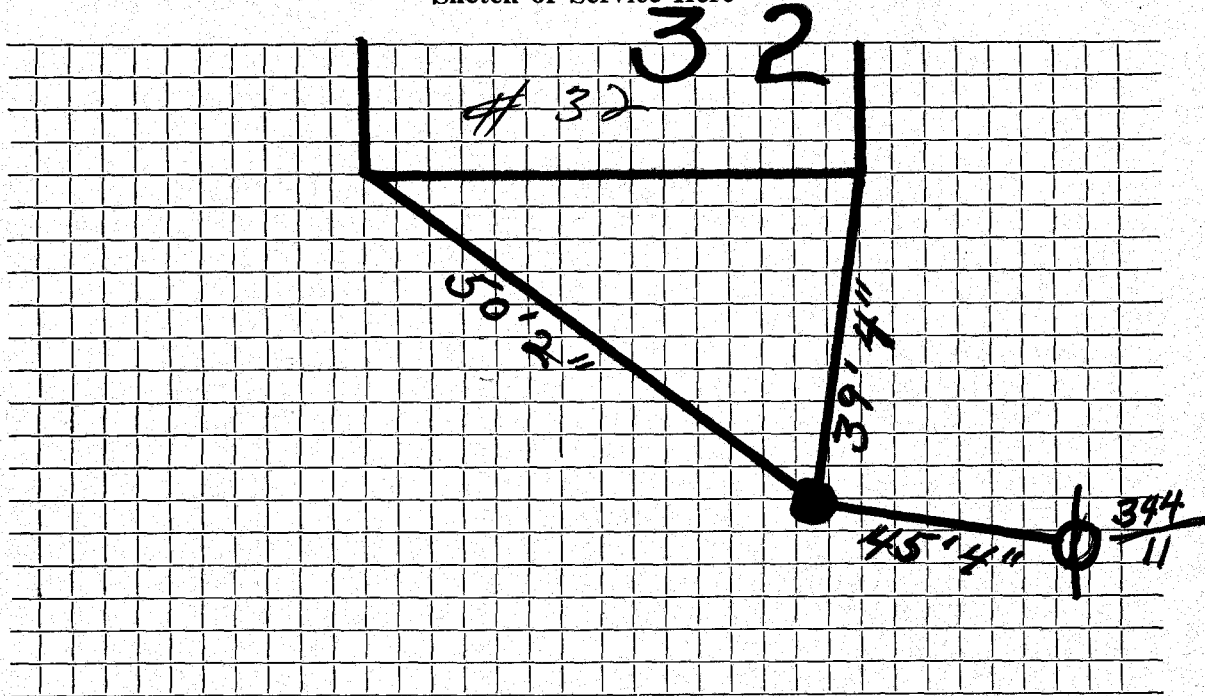

Connection made in ..... Street. Work completed .....

Remarks: .....

.....

.....