

WATER SERVICE RECORD

Name Battleview Park Realty Trust

Service No. 303

Address 33 Young Street

7498

Location

~~Repair - Renewal~~ - New Service

Comm. 12-3-56


Date	Material	Amount	Total	Date	Amount
10/6/56	Labor	14 20		9-27-56	Deposit \$ 75 00
	10% overhead	1 42	15 62	12-3-56	Refund 33 59
	28' - 3/4" Copper tubing @ .4850	13.58	13.58		NON CHARGE 41 41
	1 - 3/4" Cx 1/2 I.W.H. Stop & Waste	4 96	4 96	10/6/56	Labor 34 10
	1 hr. trucking		75	36' - 3/4" Copper tubing @ .4850	17 46
	1 hr. Town Shovel		6 50	1 - 3/4" C. Curb Cock	4 64
			41 41	1 - 3/4" C. Corp Cock	5 94
				1 Box & Rod	4 62
				1 - 1/2 Straight tailpiece	50
				1 - 1/2 Offset tailpiece	50
				1 hr. Town Shovel	6 50
					74 26

DATE _____

TOWN OF LEXINGTON — BOARD OF PUBLIC WORKS

WATER DIVISION

Sketch of Service Here

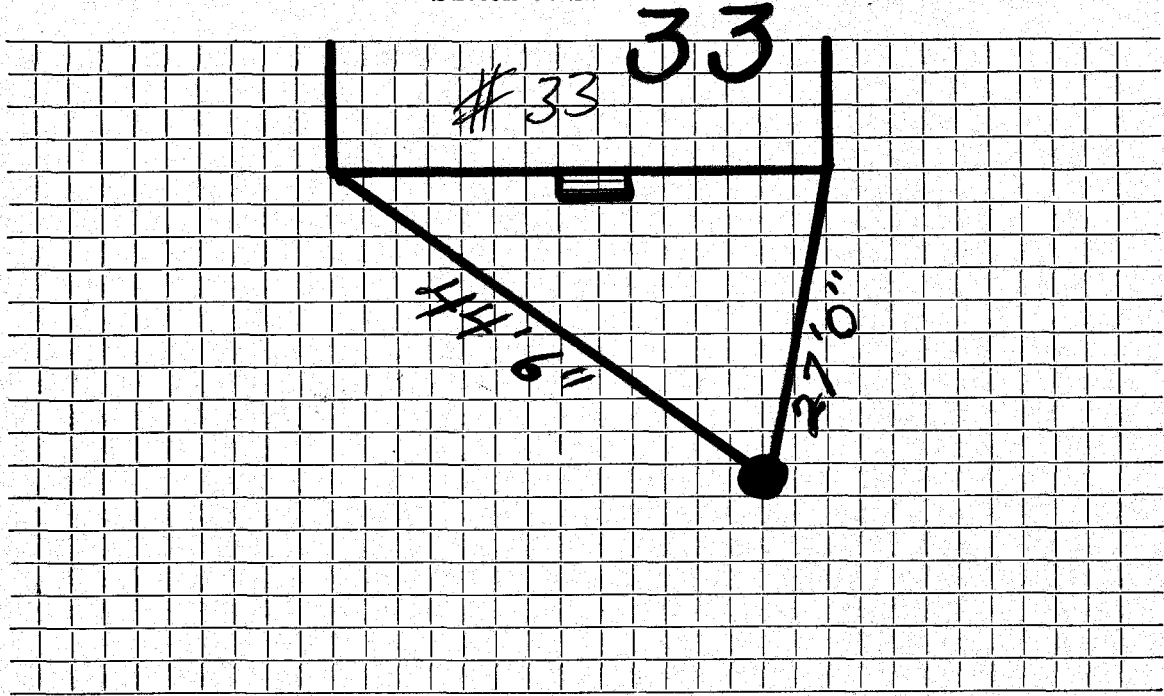

Connection made in Street. Work completed

Remarks:
.....
.....