


TOWN OF LEXINGTON - BOARD OF PUBLIC WORKS
WATER DIVISION

SKETCH OF SERVICE HERE

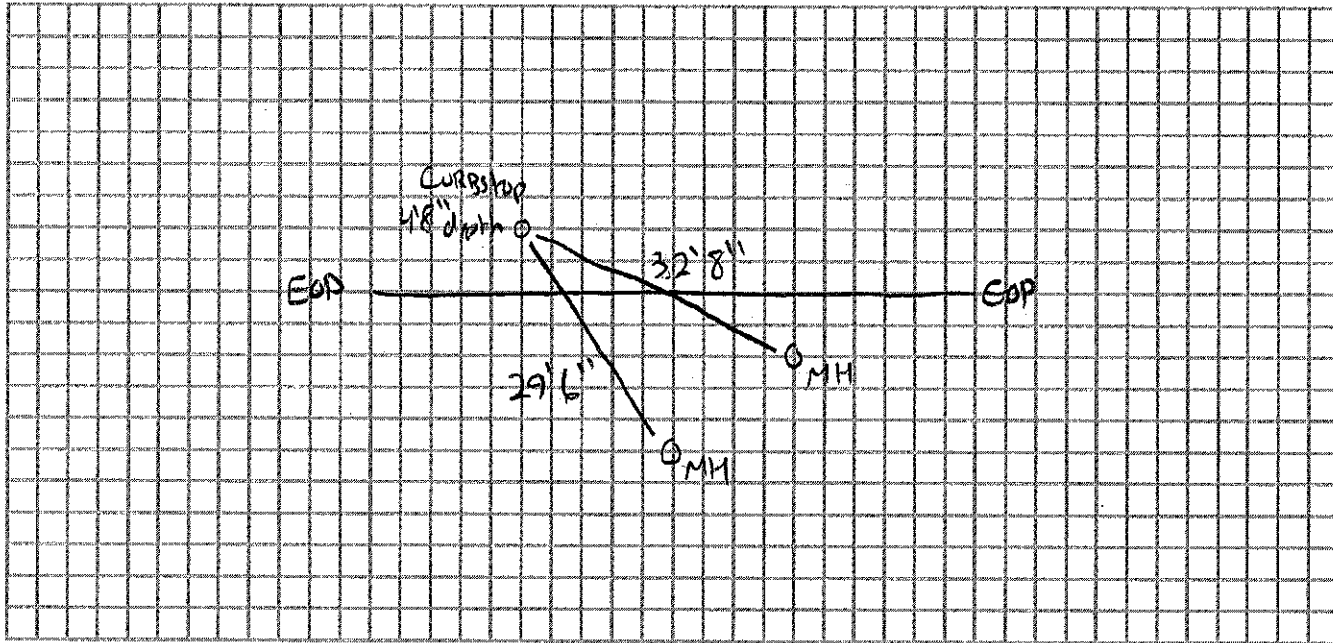

Connection made in: YOUNG ST Street. Work completed:

Remarks: INSTALLED BY McLAUGHLIN

MEASURED FROM CENTER OF MANHOLE COVER