

## WATER SERVICE RECORD

Name Louis Guadagno

Service No. 56

Address 5 Young Street

Location Lot #24

~~Repair, Renewal~~ New Service

DeFlice Bros. Permit #350


AUG 9 1965

Date	Material	Amount	Total	Date		Amount
7-28-61	Labor	5.73		6-18-65	Deposit	58.35
	10% O.H.	.57	6.30			
	7' 3/4" Copper tubing @.42		2.94			
	1 Hr. Trucking @3.00		<u>3.00</u>		NON CHARGE	
	BILL WHEN CONNECTED		12.24	7-28-61	Labor	15.54
6-25-65	43' 3/4" Copper tubing				19' 3/4" Copper tubing @.42	7.98
					1 3/4" C Corp Cock	4.91
					1 3/4" C Curb Cock	6.28
					1 Box & Rod	4.90
					1 hr. Town Shovel @6.50	6.50
				8-27-73	New Service (Outside)	46.11
					27' 3/4" Copper	
					1 3/4" C. Corp Cock	

TOWN OF LEXINGTON — BOARD OF PUBLIC WORKS

WATER DIVISION

Sketch of Service Here

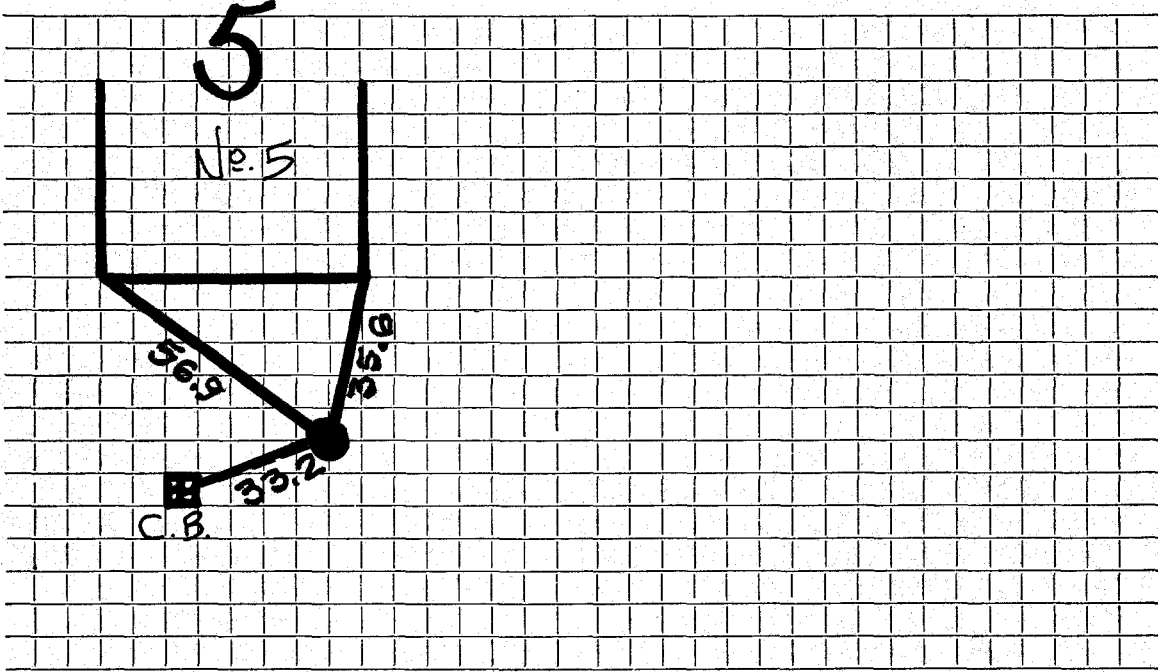

Connection made in ..... Street.      Work completed .....

Remarks: .....  
.....  
.....