

WATER SERVICE RECORD

1376
Service No.

57

Name Louis Guadagno

Address 7 Young Street

Location Lot 51

~~Repair~~ - New Service

DeFlice Bros. Permit #351


AUG 9 1965

Date	Material	Amount	Total	Date	Amount	
7-29-61	Labor	5.73		6-18-65	Deposit	54.64
	10% O.H.	.57	6.30			
	7' 3/4" Copper tubing @.42		2.94			
	1 hr. Trucking @3.00		<u>3.00</u>		NON CHARGE	
	BILL WHEN CONNECTED		12.24	7-29-61	Labor	13.09
6-25-65	45' 3/4# Copper tubing			16'	3/4" Copper tubing @.42	6.72
				1	3/4" C Curb Cock	6.28
				1	3/4" C Corp Cock	4.91
				1	Box & Rod	4.90
				1	hr. Tom Shovel @6.50	<u>6.50</u>
						42.40

TOWN OF LEXINGTON — BOARD OF PUBLIC WORKS

WATER DIVISION

Sketch of Service Here

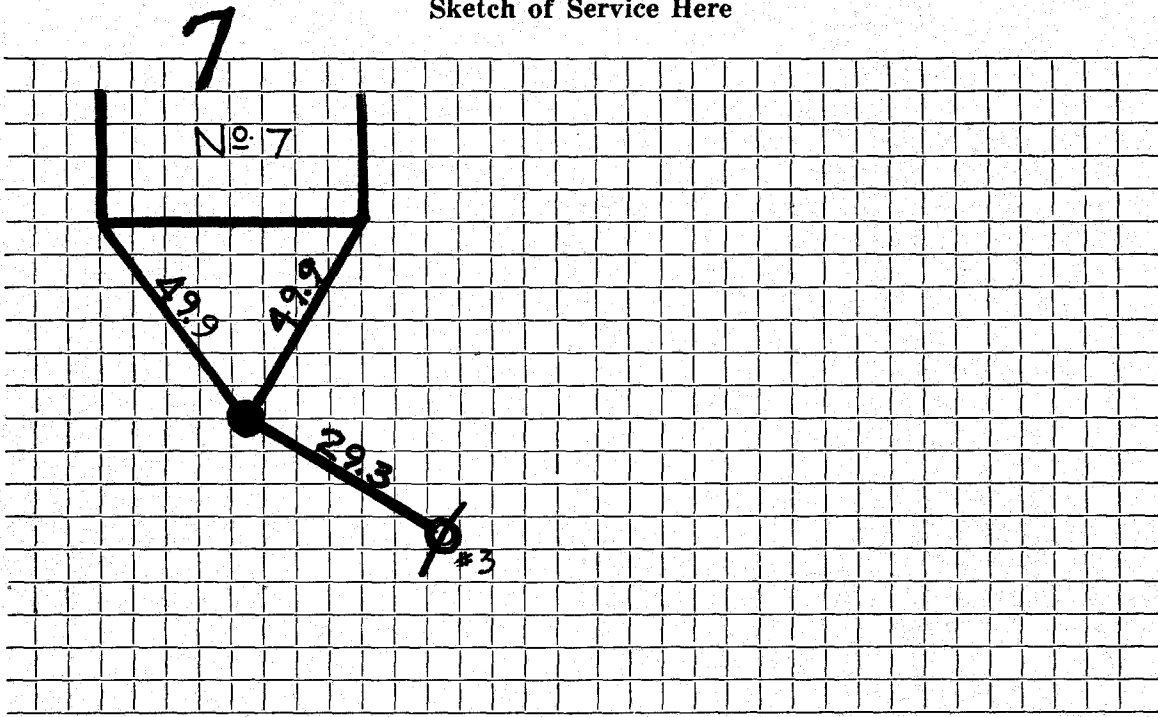

Connection made in Street. Work completed

Remarks:
.....
.....